

LEE
P 45

MISSISSIPPI BOARD OF WATER COMMISSIONERS

7-18-62

CODED

WATER WELL DRILLERS LOG

HERNDON WELL & SUPPLY CO.


Date July 18, 1962, Driller: _____ P. O. BOX 42 County Leone

SHANNON, MISSISSIPPI

(1) Owner of Land: <u>Burke Prestley</u> (Name)	Description & Color of Materials Sand, Clay, Red Clay, Shell, etc.	Thick- ness Feet	Depth Feet
<u>Nettleton, Miss.</u> (Address)	<u>Super sand & clay</u>		<u>0</u>
(2) Location: <u>1/4, 1/4, Sec 29 T11 S7E</u> <u>1 1/2 miles E</u> of <u>Nettleton</u> (distance) (direction) (Nearest Town)	<u>Blue rock</u> <u>Sand</u>	<u>20</u> <u>80</u>	
(3) Topography: <u>Flat</u> (Hilly) (Flat) (Level)	<u>8</u>		
(4) Purpose of Well: <u>Domestic</u> (Domestic Irrigation Municipal, Industrial, Other)	<u>Bottom</u>	<u>200</u>	

Information upon completion of well:

- (1) Diameter 4 inches.
- (2) Total Depth 200 feet.
- (3) Water Level 90 feet below top of ground.
- (4) Cased to 25' 4", Size 4".
- (5) Screen: Size _____, Length _____.
- (6) Were any formations sealed against pollution?
yes, _____ no.

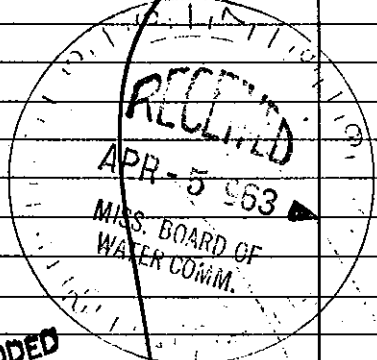

CODED

If YES depth of formation 20'

Why Super & Sand

Drillers Remarks: _____

318

Well No.

(Use Back Side)

Mail this copy to Board of Water Commissioners 429 Miss. St. Jackson, Miss