

LEE
P 46
10-62

MISSISSIPPI BOARD OF WATER COMMISSIONERS

WATER WELL DRILLERS LOG
HERNDON WELL & SUPPLY CO.

Date: 02 ^{CODED} 1962, Driller: SHANNON, MISSISSIPPI County Free
(Name)

P. O. BOX 42

(1) Owner of Land:	Description & Color of Materials Sand, Clay, Red Clay, Shell, etc.	Thick- ness Feet	Depth Feet
<u>W. A. Bryant</u> (Name) <u>Nettleton, Miss</u> (Address)	<u>sand & clay</u>		<u>0</u>
(2) Location: <u>1/4</u> , <u>1/4</u> , Sec. <u>8</u> T. <u>115</u> R. <u>11E</u> <u>3</u> miles <u>NE</u> of <u>Nettleton</u> (distance) (direction) (Nearest Town)	<u>Blow sand</u>		<u>36</u>
(3) Topography: <u>Flat</u> (Hilly) (Flat) (Level)	<u>sand</u>		<u>100</u>
(4) Purpose of Well: <u>Domestic</u> (Domestic Irrigation Municipal, Industrial, Other)	<u>Bottom</u>		<u>220</u>

Information upon completion of well:


- (1) Diameter 4 inches.
- (2) Total Depth 220 feet.
- (3) Water Level 80 feet below top of ground.
- (4) Cased to 42' 3", Size 4.
- (5) Screen: Size _____, Length _____.
- (6) Were any formations sealed against pollution?
✓ yes, _____ no.

If YES depth of formation 36'

Why surface sand

Drillers Remarks:

3RD

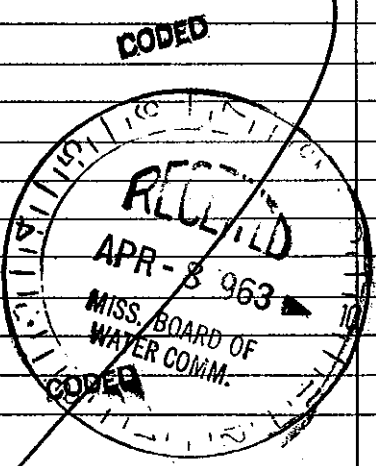

(Use Back Side)

Well No.

Mail this copy to Board of Water Commissioners 429 Miss. St. Jackson, Miss