

LEE
P 48

MISSISSIPPI BOARD OF WATER COMMISSIONERS

CODED

11-3-62

WATER WELL DRILLERS LOG

Date ~~Nov 3~~ Nov 3, 1962, Driller HERNDON WELL & SUPPLY CO. County Lee

HERNDON WELL & SUPPLY CO.
P. O. BOX 42
STANNON, MISSISSIPPI

(1) Owner of Land:	Description of Materials Sand, Clay, Red Clay, Shell, etc.	Thick- ness Feet	Depth Feet
Joe Lamb	Surface sand		0
Nettleton, Miss	+ clay		
(2) Location: 1/4, 1/4, Sec. 29 T. 115 R. 1E	Phosphorite		30
2 miles E of Nettleton	Sand		50
(3) Topography: Flat	Bottom		160
(4) Purpose of Well: Domestic			

Information upon completion of well:


- (1) Diameter 4 inches.
- (2) Total Depth 160 feet.
- (3) Water Level 60 feet below top of ground.
- (4) Cased to 33'6", Size 4"
- (5) Screen: Size _____, Length _____.
- (6) Were any formations sealed against pollution?
 yes, _____ no.

If YES depth of formation 30 ft

Why surface sand

Drillers Remarks:

323

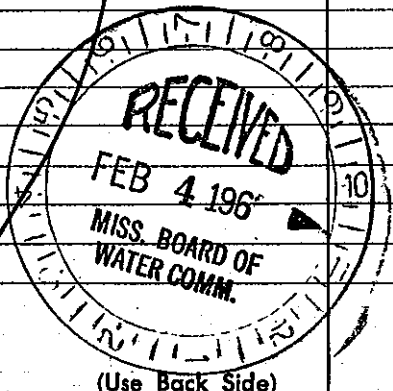

Well No.

Mail this copy to Board of Water Commissioners 429 Miss. St. Jackson, Miss