

LEE
P 49

11-15-62

MISSISSIPPI BOARD OF WATER COMMISSIONERS

WATER WELL DRILLERS LOG

Date: Nov 15, 1962, Driller: Johnny Webb County Lee

(Name)

(1) Owner of Land: Ms. Jernigan
(Name)
Nittleton, Mississippi
(Address)

(2) Location: 1/4, 1/4, Sec. 29 T. 4 R. 2
3 1/2 miles E of Nittleton
(distance) (direction) (Nearest Town)

(3) Topography: (Hilly) (Flat) (Level)

(4) Purpose of Well: Domestic
(Domestic Irrigation, Municipal, Industrial, Other)

Description & Color of Materials Sand, Clay, Red Clay, Shell, etc.	Thick- ness Feet	Depth Feet
top soil	0	6'
Red clay, sand	6'	30'
blue sand	30'	70'
sand	70'	150'

Information upon completion of well:

(1) Diameter: 4 inches.

(2) Total Depth: 150' feet.

(3) Water Level: 40 feet below top of ground.

(4) Cased to 42', Size 4"

(5) Screen: Size _____, Length _____


(6) Were any formations sealed against pollution?
_____ yes, _____ no.

If YES depth of formation _____

Why _____

Drillers Remarks: _____

324

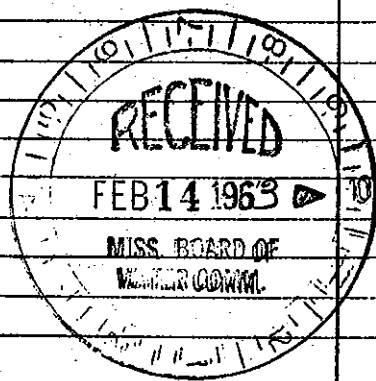

(Use Back Side)

Well No.

Mail this copy to Board of Water Commissioners 429 Miss. St. Jackson, Miss.