

MISSISSIPPI BOARD OF WATER COMMISSIONERS

LEE

P 51

2-9-63

WATER WELL DRILLERS LOG

HERNDON WELL & SUPPLY CO.

Date: Feb 9, 1963, Driller: P. O. BOX 42 County Lee  
SHANNON, MISSISSIPPI

Contractor	Description & Color of Materials	Thick-ness Feet	Depth Feet
(1) Owner of Land: <u>A. D. Payne</u> (Name)	surface sand		0
<u>Nettleton, Miss.</u> (Address)	+ clay		
(2) Location: <u>1/4</u> , <u>1/4</u> , Sec <u>19</u> T <u>18</u> R <u>7E</u>	Blue water		18
<u>2</u> miles <u>NE</u> of <u>Nettleton</u> (distance) (direction) (Nearest Town)	+ sand		80
(3) Topography: <u>Flat</u> (Hilly) (Flat) (Level)	+ water		200
(4) Purpose of Well: <u>Domestic</u> (Domestic Irrigation Municipal, Industrial, Other)			

Information upon completion of well:

(1) Diameter 4 inches.

(2) Total Depth 200 feet.

(3) Water Level 20 feet below top of ground.

(4) Cased to 21'6", Size 4"

(5) Screen: Size —, Length —

(6) Were any formations sealed against pollution?  
 yes,  no.


If YES depth of formation 18'

Why surface & sand

Drillers Remarks:

326

DODED

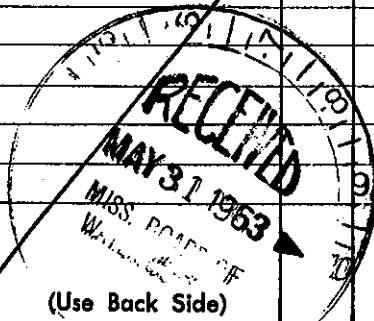

Well No.

Mail this copy to Board of Water Commissioners 429 Miss. St. Jackson, Miss!