

LEE

MISSISSIPPI BOARD OF WATER COMMISSIONERS

P 53

9-16-63

WATER WELL DRILLERS LOG

CODED

HERNDON WELL & SUPPLY CO

Date: 9/16, 1963, Driller: P.O. BOX 42, County Lee, SHANNON, MISSISSIPPI

(1) Owner of Land: <u>Leuco Adams</u> (Name)	Description & Color of Materials Sand, Clay, Red Clay, Shell, etc.	Thick- ness Feet	Depth Feet
<u>At Nettleton, Miss</u> (Address)	<u>surface sand & clay</u>		0
(2) Location: <u>1/4, 1/4, Sec 19 T 115 R 7E</u> <u>3 miles NE</u> of <u>Nettleton</u> (distance) (direction) (Nearest Town)	<u>Blue sand</u>		33
(3) Topography: <u>Hilly</u> (Hilly) (Flat) (Level)	<u>sand</u>		98
(4) Purpose of Well: <u>Domestic</u> (Domestic Irrigation Municipal, Industrial, Other)	<u>Bottom</u>		200

Information upon completion of well:


- (1) Diameter 4 inches.
- (2) Total Depth 200 feet.
- (3) Water Level 70 feet below top of ground.
- (4) Cased to 36', Size 4".
- (5) Screen: Size , Length .
- (6) Were any formations sealed against pollution?
 yes, no.

If YES depth of formation 33'


Why surface sand

Drillers Remarks:

329

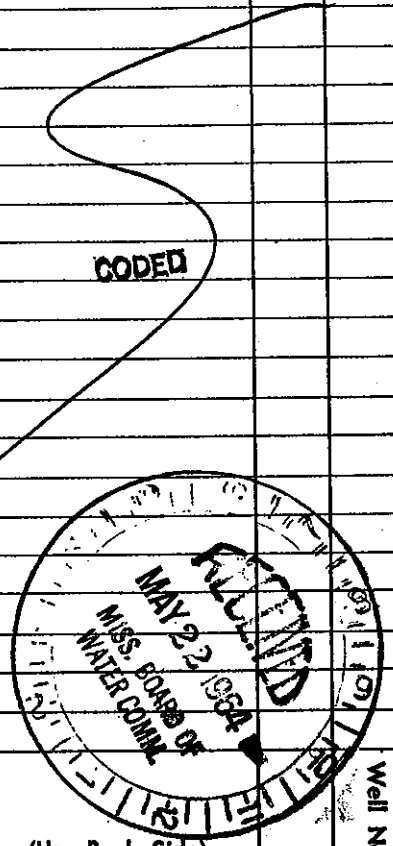

CODED

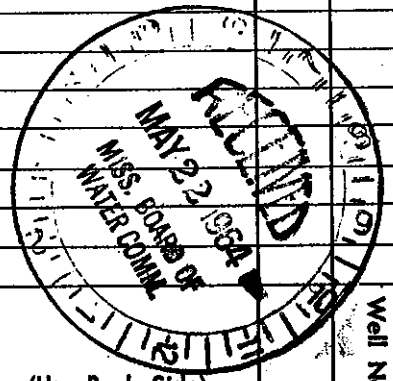

Well No.

(Use Back Side)

Mail this copy to Board of Water Commissioners 429 Miss. St. Jackson, Miss.