

LEE

MISSISSIPPI BOARD OF WATER COMMISSIONERS

P54

WATER WELL DRILLERS LOG

5-31-64

CODED

Date: 5/31, 1964, Driller: HERNDON WELL & SUPPLY CO. County: Lee

P.O. BOX 42 SHANNON MISSISSIPPI

(1) Owner of Land <i>William D. Rogers</i> (Name)	Description & Color of Materials Sand, Clay, Red Clay, Shell, etc.	Thick- ness Feet	Depth Feet
<i>Nettleton, Miss.</i> (Address)	<i>Surface sand & clay</i>		0
(2) Location: $\frac{1}{4}$, $\frac{1}{4}$, Sec <i>30 11S R 7E</i> <i>1 1/2</i> miles <i>E</i> , of <i>Nettleton</i> (distance) (direction) (Nearest Town)	<i>Blue rock</i>		18
(3) Topography: <i>flat</i> (Hilly) (Flat) (Level)	<i>sand</i>		100
(4) Purpose of Well: <i>Domestic</i> (Domestic Irrigation, Municipal, Industrial, Other)	<i>to</i>		200

Information upon completion of well:

- (1) Diameter *4* inches.
- (2) Total Depth *200* feet.
- (3) Water Level *50* feet below top of ground.
- (4) Cased to *21' 3"*, Size *4*.
- (5) Screen: Size _____, Length _____.
- (6) Were any formations sealed against pollution?
 yes, _____ no.


If YES depth of formation *18'*

Why *Surface & sand*

Drillers Remarks:

330

CODED

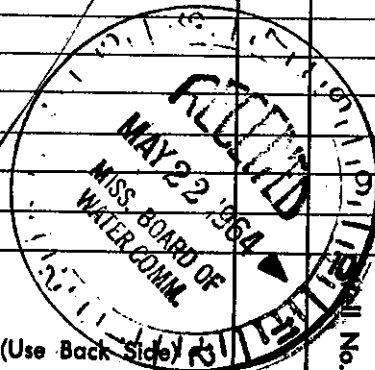

(Use Back Side)

Mail this copy to Board of Water Commissioners 429 Miss. St. Jackson, Miss.