

LEE MISSISSIPPI BOARD OF WATER COMMISSIONERS

P55

5-15-65 WATER WELL DRILLERS LOG

Herndon-Homan Well & Supply, Inc.

Date: May 15, 1965 Driller: Lee P. O. Box 42 County Lee

SHANNON, MISSISSIPPI 38868

(1) Owner of Land: <u>Oles Sullivan</u> (Name)	Description & Color of Materials Sand, Clay, Red Clay, Shell, etc.	Thick- ness Feet	Depth Feet
<u>Nettleton, Miss</u> (Address)	<u>sand & clay</u>	<u>0-26</u>	<u>0-26</u>
(2) Location: <u>1/4, 1/4, Sec 29 T 11 S R 7 E</u>	<u>Blue clay</u>	<u>26-90</u>	<u>26-90</u>
<u>1 1/2</u> miles <u>E</u> of <u>Nettleton</u> (distance) (direction) (Nearest Town)	<u>Sand</u>	<u>90-180</u>	<u>90-180</u>
(3) Topography: <u>Flat</u> (Hilly) (Flat) (Level)	<u>Bottom</u>	<u>180</u>	<u>180</u>
(4) Purpose of Well: <u>Domestic</u> (Domestic Irrigation Municipal, Industrial, Other)			


Information upon completion of well:

- (1) Diameter 4 inches.
- (2) Total Depth 180 feet.
- (3) Water Level 50 feet below top of ground.
- (4) Cased to 24', Size 4"
- (5) Screen: Size —, Length —
- (6) Were any formations sealed against pollution?
 yes, no.

If YES depth of formation 26'

Why surface & sand

Drillers Remarks:

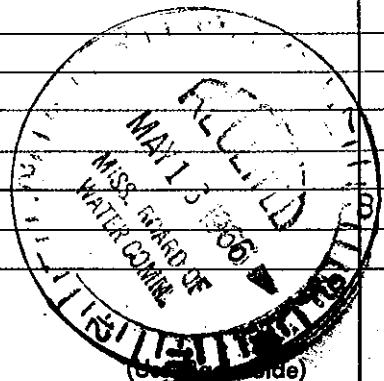

331

Well No.

Mail this copy to Board of Water Commissioners 429 Miss. St. Jackson, Miss.