

LEE
P 56
7-2-65

MISSISSIPPI BOARD OF WATER COMMISSIONERS

WATER WELL DRILLERS LOG

Date: July 2, 1965 Driller: Herndon-Homan Well & Supply, Inc.
SHANNON, MISSISSIPPI 38868 P. O. Box 42 County Lee

| (1) Owner of Land: Eugene Sullivan (Name) | Description & Color of Materials Sand, Clay, Red Clay, Shell, etc. | Thick- ness Feet | Depth Feet |
|--|---|------------------------|---------------|
| (Contractor) Nettleton Miss (Address) | surface sand & clay | | 0-45 |
| (2) Location: 1/4, 1/4, Sec 30 T 15 N R 7 E | Blue clay | | 45-55 |
| 2 miles N. East of Nettleton (distance) (direction) (Nearest Town) | Sand | | 55-160 |
| (3) Topography: Flat (Hilly) (Flat) (Level) | Bottom | | |
| (4) Purpose of Well: Domestic (Domestic Irrigation Municipal, Industrial, Other) | | | |

Information upon completion of well:


- (1) Diameter 4 inches.
- (2) Total Depth 160 feet.
- (3) Water Level 40' feet below top of ground.
- (4) Cased to 49' 1", Size 4"
- (5) Screen: Size —, Length —
- (6) Were any formations sealed against pollution?
 yes, no.

If YES depth of formation 45'

Why surface + sand

Drillers Remarks:

332

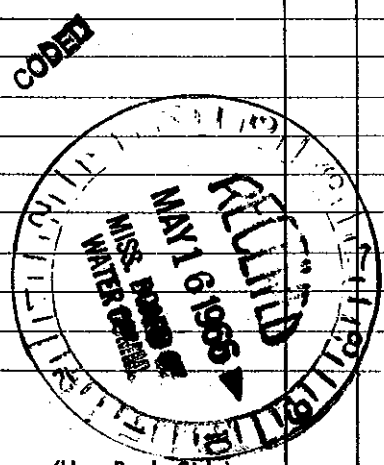

(Use Back Side)

Well No.

Retain this copy for your office files.