

LEE MISSISSIPPI BOARD OF WATER COMMISSIONERS

P57

7-27-65

WATER WELL DRILLERS LOG

Date July 27 1965 Driller: Herndon-Homan Well Supply, Inc.
SHANNON, MISSISSIPPI 38868 County Lee
(Name)

(1) Owner of Land	Description & Color of Materials Sand, Clay, Red Clay, Shell, etc.	Thick- ness Feet	Depth Feet
<u>Fuzore Sullivan</u> <small>(Name)</small> <u>Nettleton, Miss.</u> <small>(Address)</small>	<u>surface sand & clay</u>	<u>0 - 20</u>	<u>0 - 20</u>
(2) Location: <u>1/4, 1/4, Sec 29 T. 11 S. R. 7 E</u>	<u>Blue clay</u>	<u>20 - 90</u>	<u>20 - 90</u>
<u>1 1/2</u> miles <u>NE</u> of <u>Nettleton</u> <small>(distance) (direction) (Nearest Town)</small>	<u>sand</u>	<u>90 - 180</u>	<u>90 - 180</u>
(3) Topography: <u>Flat</u> <small>(Hilly) (Flat) (Level)</small>	<u>Bottom</u>	<u>180</u>	<u>180</u>
(4) Purpose of Well: <u>Domestic</u> <small>(Domestic Irrigation Municipal, Industrial, Other)</small>			

Information upon completion of well:


- (1) Diameter 4 inches.
- (2) Total Depth 180 feet.
- (3) Water Level 25' feet below top of ground.
- (4) Cased to 35' 6", Size 4"
- (5) Screen: Size , Length
- (6) Were any formations sealed against pollution?
 yes, no.

If YES depth of formation

Why

Drillers Remarks:

CODES

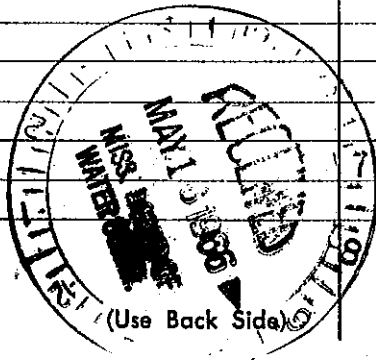

Well No.

333

Retain this copy for your office files.