


LEE MISSISSIPPI BOARD OF WATER COMMISSIONERS

P58
10-11-65


WATER WELL DRILLERS LOG

Herdon-Homan Well & Supply, Inc.

Date Oct 11, 1965, Driller: P. O. Box 42 County Lee
SHANNON, MISSISSIPPI 38868

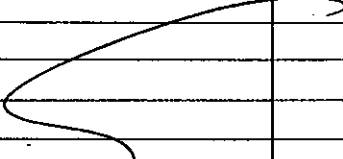(1) Owner of Land:	Description & Color of Materials Sand, Clay, Red Clay, Shell, etc.	Thick- ness Feet	Depth Feet
<u>S. G. Coggin</u> (Name) <u>Nettleton, Miss</u> (Address)	<u>surface mud & clay</u>	<u>0</u>	<u>8</u>
	<u>blue clay & mud</u>	<u>8</u>	<u>50</u>
(2) Location: <u>1/4, 1/4, Sec. 17 T11S R1E</u> <u>2 1/2 miles NE</u> , of <u>Nettleton</u> (distance) (direction) (Nearest Town)	<u>blue clay</u>	<u>50</u>	<u>80</u>
	<u>sand</u>	<u>80</u>	<u>180</u>
	<u>bottom</u>	<u>180</u>	<u>180</u>
(3) Topography: <u>flat</u> (Hilly) (Flat) (Level)			
(4) Purpose of Well: <u>Domestic</u> (Domestic Irrigation Municipal, Industrial, Other)			
Information upon completion of well:			
(1) Diameter <u>4</u> inches.			
(2) Total Depth <u>180</u> feet.			
(3) Water Level <u>60</u> feet below top of ground.			
(4) Cased to <u>556"</u> , Size <u>4"</u>			
(5) Screen: Size <u>—</u> , Length <u>—</u>			
(6) Were any formations sealed against pollution?			
<u>yes</u> , <u>no</u> .			
If YES depth of formation <u>50'</u>			
Why <u>surface & sand</u>			
Drillers Remarks:			
334			

CODED

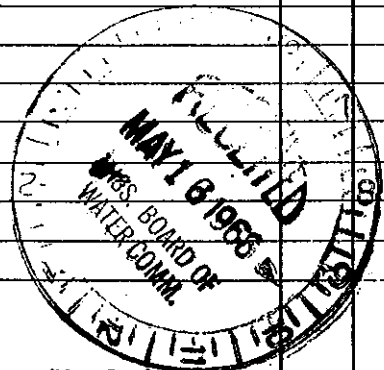

Well No.

(Use Back Side)

Mail this copy to Board of Water Commissioners 429 Miss. St. Jackson, Miss.