

LEE MISSISSIPPI BOARD OF WATER COMMISSIONERS

P59  
11-11-65 CODED


WATER WELL DRILLERS LOG

Herndon-Homan Well & Supply, Inc.

Date: Nov. 11, 1963, Driller: SEANNON P. O. Box 42 County Lee  
MISSISSIPPI 38868

(1) Owner of Land: <u>Dennis Gimble</u> (Name)	Description & Color of Materials Sand, Clay, Red Clay, Shell, etc.	Thick- ness Feet	Depth Feet
<u>Nettleton, Miss.</u> (Address)	<u>red sand &amp; clay</u>	<u>0-25</u>	<u>0-25</u>
(2) Location: <u>2 1/4</u> Sec. <u>28</u> T. <u>11 S.</u> R. <u>7 E.</u>	<u>blue clay</u>	<u>25-70</u>	<u>25-70</u>
<u>2 1/2</u> miles <u>E</u> , of <u>Nettleton</u> (distance) (direction) (Nearest Town)	<u>sand</u>	<u>70-160</u>	<u>70-160</u>
(3) Topography: <u>Hilly</u> (Hilly) (Flat) (Level)	<u>Bottom</u>	<u>160</u>	<u>160</u>
(4) Purpose of Well: <u>Domestic</u> (Domestic Irrigation Municipal, Industrial, Other)			
Information upon completion of well:			
(1) Diameter <u>4</u> inches.			
(2) Total Depth <u>160</u> feet.			
(3) Water Level <u>90</u> feet below top of ground.			
(4) Cased to <u>29' 6"</u> , Size <u>4"</u>			
(5) Screen: Size <u>    </u> , Length <u>    </u>			
(6) Were any formations sealed against pollution? <u>1</u> yes, <u>    </u> no.			
If YES depth of formation <u>25'</u>			
Why <u>Surfer &amp; sand</u>			
Drillers Remarks:			
<u>335</u>			

CODED

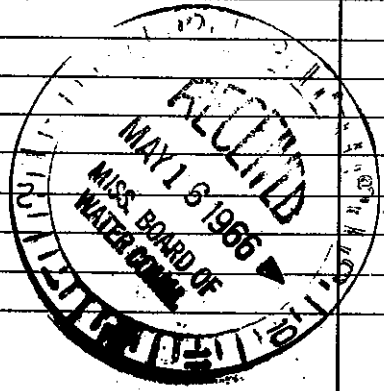

(Use Back Side)

Well No.

Mail this copy to Board of Water Commissioners 429 Miss. St. Jackson, Miss.