

LEE  
P 60  
5-17-62

MISSISSIPPI BOARD OF WATER COMMISSIONERS

WATER WELL DRILLERS LOG

HERNDON WELL & SUPPLY CO.

Date: May 17 1962 Driller: P. O. BOX 42 County: Lee  
SRANNON, MISSISSIPPI


(1) Owner of Land: Marvin Hall  
(Name)  
Nettleton, Miss  
(Address)  
(2) Location: 1/4, 1/4, Sec 20 T 15 N R 7 E  
2 miles NE, of Nettleton  
(distance) (direction) (Nearest Town)  
(3) Topography: Hilly  
(Hilly) (Flat) (Level)  
(4) Purpose of Well: Domestic  
(Domestic Irrigation  
Municipal, Industrial, Other)

Description & Color of Materials Sand, Clay, Red Clay, Shell, etc.	Thick- ness Feet	Depth Feet
<u>surface sand &amp; clay</u>		<u>0</u>
<u>Blue water</u>		<u>28</u>
<u>sand</u>		<u>120</u>
<u>Bottom</u>		<u>240</u>

Information upon completion of well:

(1) Diameter 4 inches.  
(2) Total Depth 240 feet.  
(3) Water Level 50 feet below top of ground.  
(4) Cased to 30' 5", Size 4"  
(5) Screen: Size —, Length —  
(6) Were any formations sealed against pollution?  
 yes,  no.

If YES depth of formation 28 ft.  
Why surface sand  
Drillers Remarks: \_\_\_\_\_

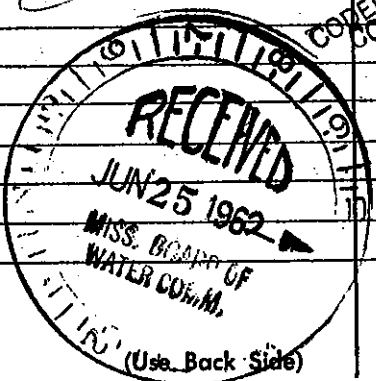

360

Well No.