

MISSISSIPPI BOARD OF WATER COMMISSIONERS

WATER WELL DRILLERS LOG

HERNDON WELL & SUPPLY CO.

Date Aug 25, 1962, Driller: P O BOX 42 County Lee
SHANNON, MISSISSIPPI

Contractor	Description & Color of Materials Sand, Clay, Red Clay, Shell, etc.	Thick- ness Feet	Depth Feet
(1) Owner of Land: <u>A. De Payne</u> (Name) <u>Nettles, Miss</u> (Address)	<u>surface sand</u> <u>& clay</u>		<u>0</u>
(2) Location: <u>1/4, 1/4, Sec. 30 T 11 S R 4 E</u> <u>11-5-6</u> <u>1/2</u> miles <u>—</u> of <u>Nettles</u> (distance) (direction) (Nearest Town)	<u>Blue sand</u> <u>& sand</u>		<u>18</u> <u>60</u>
(3) Topography: <u>Flat</u> (Hilly) (Flat) (Level)	<u>Bottom</u>		<u>180</u>
(4) Purpose of Well: <u>Domestic</u> (Domestic Irrigation Municipal, Industrial, Other)			


Information upon completion of well:

- (1) Diameter 4 inches.
- (2) Total Depth 180 feet.
- (3) Water Level 60 feet below top of ground.
- (4) Cased to 2' 2", Size 4".
- (5) Screen: Size —, Length —.
- (6) Were any formations sealed against pollution?
 yes, no.

If YES depth of formation 18'

Why surface & sand

Drillers Remarks: _____

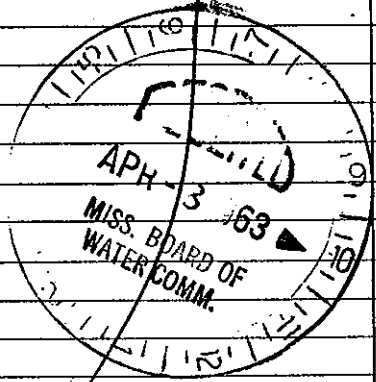

287 ?

(Use Back Side)

Well No.

Mail this copy to Board of Water Commissioners 429 Miss. St. Jackson, Miss