

MISSISSIPPI BOARD OF WATER COMMISSIONERS

LEE
POI
7-15-60

WATER WELL DRILLERS LOG

CODED

Drilled by **Herndon Well & Supply Co.**
 Driller: **SHANNON**, MISS.

Date: **July 15, 1960**

County: **Madison**

20-11
 172-13 376-10 592-6 997-2 **12**

(Name)


(1) Owner of Land: Clavis Sullivan
 (Name)
Nettleton, Miss.
 (Address)
Eureka Rd. 9632746
 (2) Location: N¹/₂ SW 1/4, Sec. 29 T11S R7E
 (distance) miles _____, of _____, of _____
 (direction) (Nearest Town)
 (3) Topography: Flat
 (Hilly) (Flat) (Level)
 (4) Purpose of Well: Home Use
 (Domestic Irrigation) (Municipal, Industrial, Other)

Description & Color of Materials Sand, Clay, Red Clay, Shell, etc.	Thick- ness Feet	Depth Feet
<u>Sand & Clay</u>		
<u>8</u>		<u>21</u>
<u>Blk - Rock</u>		<u>21</u>
<u>8</u>		<u>40</u>
<u>SAND</u>		<u>40</u>
<u>8</u>		
<u>Bottom</u>		<u>168</u>

Information upon completion of well:

(1) Diameter 4 inches.
 (2) Total Depth 168 feet.
 (3) Water Level 60 feet below top of ground.
 (4) Cased to 21 ft Size 4"
 (5) Screen: Size _____, Length _____
 (6) Were any formations sealed against pollution?
X yes, _____ no.
 If YES depth of formation 21 ft
 Why Surface
 Drillers Remarks:

CODED

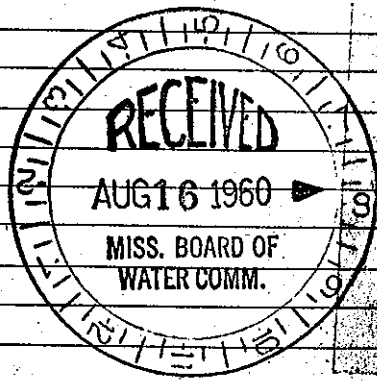

(Use Back Side)

Mail this copy to Board of Water Commissioners 429 Miss