

MISSISSIPPI BOARD OF WATER COMMISSIONERS

LEE
 5-16-61
 WATER WELL DRILLERS LOG

Date: May 16, 1961, Driller: Ewing Gaslocounty Lee
 (Name)

(1) Owner of Land: Claude Hawkins	Description & Color of Materials Sand, Clay, Red Clay, Shell, etc.	Thick- ness Feet	Depth Feet
(Name) Nettleton, Miss.	clay		
(Address)	Blue clay	0	20
(2) Location: 1/4, 1/4, Sec. 29 T. R.	Sand	20	55
3 miles E of Nettleton		55	185
(3) Topography: (Hilly) (Flat) (Level)			
(4) Purpose of Well: Household (Domestic Irrigation, Municipal, Industrial, Other)			

Information upon completion of well:

(1) Diameter 4 inches.

(2) Total Depth 185 feet.

(3) Water Level 29 feet below top of ground.

(4) Cased to 59'6", Size


(5) Screen: Size, Length

(6) Were any formations sealed against pollution?
 yes, no.

If YES depth of formation 59'6"

Why

Drillers Remarks:

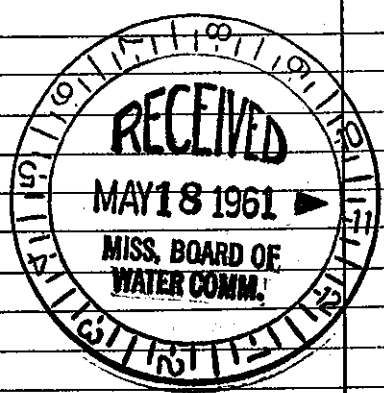

Well No.

(Use Back Side)

273

Mail this copy to Board of Water Commissioners 429 Miss. St. Jackson, Miss.