

Leflore
A 23
 10-28-68

MISSISSIPPI
 BOARD OF WATER COMMISSIONERS
 416 North State Street
 Jackson, Mississippi 39201

CODED CODED

WATER WELL DRILLERS LOG

CODED

Oct 28 19**68** **DELTA DRILLING Co.** **LEFLORE**
 date well completed firm name county well located

LANDOWNER: **L. B. JONES**
AVENT PLANTATION
MINTER CITY, MISS

description of formations encountered	from	to
gumbo	-0-	33
gravel	33	128
sand	128	163
gumbo	163	290
shale	290	386
gumbo	386	419
green sand	419	483
shale	483	580
gumbo	580	586
green sand	586	663
shale	663	714
gumbo	714	740
shale	740	753
sand w/rocks	753	792
shale	792	818
sand	818	833
shale	833	881
sand	881	920

(mailing address)

WELL LOCATION: **NE 1/4 SE 1/4**
 sec. **25** T **22** N R **2** W

_____ miles _____ of _____
 (distance) (direction) (nearest town)

WELL PURPOSE: **DOMESTIC**
 (home, irrigation, municipal, industrial)

WELL COMPLETION DATA:

- (1) diameter (inches) **4**
- (2) total depth (feet) **960'**
- (3) static water level (feet) **FLOWS** below top of ground.
- (4) casing **STEEL**, **900**
 (material) (depth)
- #3-2** if telescope see back.
 (size)
- (5) screen **20'**, **900'**
 (length) (depth to top)
- 2**, **S. STEEL**
 (size) (material)
- (6) pump _____ (HP) _____ (yield gpm)
 (type power)
- (7) electric log **NO-**
 (yes or no)
- _____ (organization running log)
- (8) how well bottom plugged **BACK**
PRESSURE VALVE

DRILLERS REMARKS: **27' LAP OF**
2" IN 3" PIPE - 38' 2"
TAIL PIPE ON BOTTOM
OF WELL.

NOV 12 1968

MISS. Bd. of
 WATER COM.

If well telescopes please sketch and show depths.

GROUND LEVEL

90' 4" BLK
A.P.I. LINE PIPE


500' 3" BLK
API LINE PIPE

27' LAP OF 2"
IN 3" PIPE

332' 2" BLK
API LINE PIPE

20' 2" SS SCR
EEN

38' 2" TAIL
PIPE

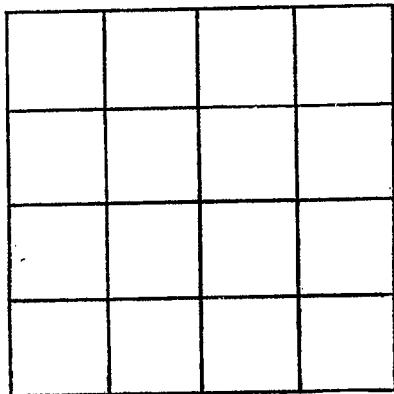

SECTION 25

Please indicate well location X.

ADDITIONAL INFORMATION

If more than one screen,
show locations of each on sketch.