

LEFLORE
A 24
4-68

MISSISSIPPI
BOARD OF WATER COMMISSIONERS
416 North State Street
Jackson, Mississippi 39201
WATER WELL DRILLERS LOG

CODED 5/18/68
well # 1
C 2658

April 20, 1968 Layne-Central Company Leflore
date well completed firm name county well located

LANDOWNER: Milburn Farms, Inc.

description of formations encountered	from	to
Clay	0	12
Coarse sand	12	42
Coarse sand, pea gravel	42	80
Coarse sand & big gravel	80	106

Ruleville, Mississippi
(mailing address)

WELL LOCATION: SE 1/4 & SE 1/4
sec. 27 T. 22 N R. 2 E
S (W)
3 miles west of Minter City
(distance) (direction) (nearest town)

WELL PURPOSE: irrigation
(home, irrigation, municipal, industrial)

WELL COMPLETION DATA:

- (1) diameter (inches) 16
- (2) total depth (feet) 106
- (3) static water level (feet) 16' 2" below top of ground.
- (4) casing steel, 56' (material), (depth)
16" (size) if telescope see back.
- (5) screen 50' (length), 106' (depth to top)
16" (size), Armco (material)
- (6) pump 50 (HP), 2000 (yield gpm)
electric (type power)
- (7) electric log no (yes or no)
(organization running log)

(8) how well bottom plugged plate


DRILLERS REMARKS:

CODED

JUN 2 1968
MISSISSIPPI
WATER BOARD

If well telescopes please sketch and show depths.

GROUND LEVEL

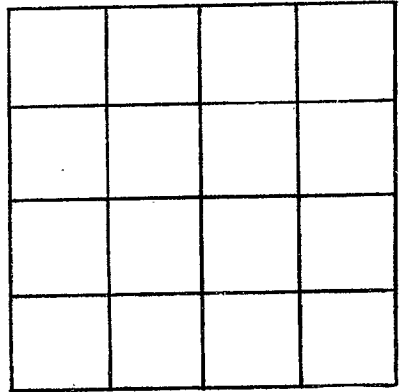

SECTION _____

Please indicate well location X.

ADDITIONAL INFORMATION

If more than one screen,
show locations of each on sketch.