

7 1024

CODED

11/18/68
Coded
2658


LEFLORE
A 24-A
5-5-68

MISSISSIPPI
BOARD OF WATER COMMISSIONERS
416 North State Street
Jackson, Mississippi 39201
WATER WELL DRILLERS LOG

June 5, 1968 Layne-Central Company Leflore
date well completed firm name county well located

LANDOWNER: Milburn Farms, Inc	description of formations encountered	from	to
Ruleville, Mississippi (mailing address)			
WELL LOCATION: sec <u>22</u> T <u>2</u> N R <u>2</u> E NW 1/4 NE 1/4 7 miles east of Ruleville (distance) (direction) (nearest town)	Coarse sand	18	45
WELL PURPOSE: <u>irrigation</u> (home, irrigation, mining , industrial)	Coarse sand, pea gravel	45	80
WELL COMPLETION DATA: (1) diameter (inches) <u>16</u>	Coarse sand, big gravel	80	102
(2) total depth (feet) <u>106</u>	Boulders	102	106
(3) static water level (feet) <u>11</u> ^{above} below top of ground.	Clay	106	
(4) casing <u>steel</u> <u>56'</u> (material) (depth) <u>16"</u> if telescope see back. (size)			
(5) screen <u>50'</u> <u>106'</u> (length) (depth to top) <u>16"</u> <u>Armco</u> (size) (material)			
(6) pump <u>50</u> <u>2,000</u> (HP) (yield gpm) <u>electric</u> (type power)			
(7) electric log <u>no</u> (yes or no) <u>plate</u> (organization running log)			
(8) how well bottom plugged <u>plate</u> ok			


CODED

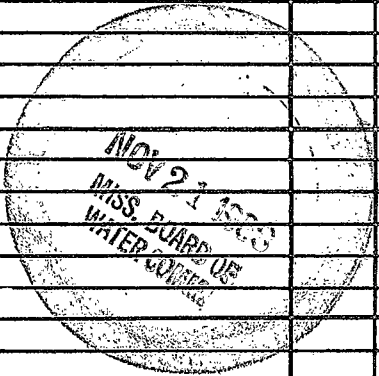

DRILLERS REMARKS:

If well telescopes please
sketch and show depths.

GROUND LEVEL

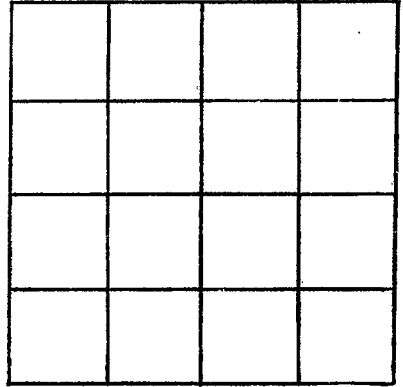

SECTION _____

Please indicate well location X.

ADDITIONAL INFORMATION

If more than one screen,
show locations of each on sketch.