


LEFLORE  
 A 25  
 11-4-68

MISSISSIPPI  
 BOARD OF WATER COMMISSIONERS  
 416 North State Street  
 Jackson, Mississippi 39201  
 WATER WELL DRILLERS LOG

CODED  
 11/18/68  
 CODED

November 4, 1968 Layne-Central Company Leflore  
 date well completed firm name county well located


| LANDOWNER: Milburn Farms, Inc.  | description of formations encountered     | from | to  |
|---|---|------|-----|
| Ruleville, Mississippi<br>(mailing address)                                 | Clay                                      | 0    | 8   |
| WELL LOCATION:<br>sec 27 T <del>2</del> N R 2 E<br>NW 1/4 NW 1/4 S W        | Fine sand                                 | 8    | 16  |
| 7 miles east of Ruleville<br>(distance) (direction) (nearest town)          | Clay balls                                | 16   | 30  |
| WELL PURPOSE: Irrigation<br>(home, irrigation, municipal, industrial)       | Coarse sand, pea gravel                   | 30   | 70  |
| WELL COMPLETION DATA:   | Coarse sand, pea gravel<br>and big gravel | 70   | 102 |
| (1) diameter (inches) 16  | Boulders                                  | 102  |     |
| (2) total depth (feet) 102  |   |      |     |
| (3) static water level (feet) 16 <del>22</del> above top of ground.         |   |      |     |
| (4) casing steel 52' (material), (depth), 16" (size) if telescope see back. |   |      |     |
| (5) screen 50' (length), 102' (depth to top), 16" (size), Armco (material)  |   |      |     |
| (6) pump 50 (HP), 2,000 (yield gpm), electric (type power)                  |   |      |     |
| (7) electric log no (yes or no), (organization running log)                 |   |      |     |
| (8) how well bottom plugged plate   |   |      |     |

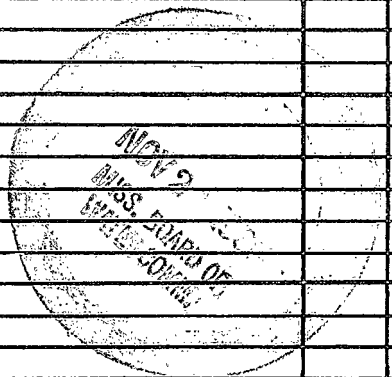

DRILLERS REMARKS:

If well telescopes please  
sketch and show depths.

GROUND LEVEL

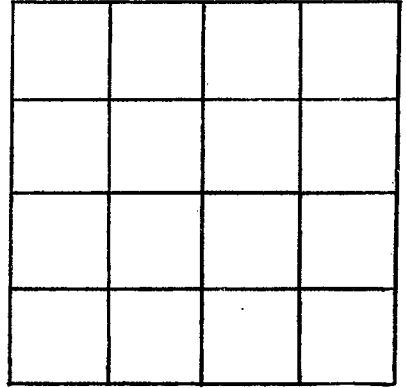

SECTION \_\_\_\_\_

Please indicate well location X.

ADDITIONAL INFORMATION

If more than one screen,  
show locations of each on sketch.