

Leflore
A 27
4-1-67

MISSISSIPPI
 BOARD OF WATER COMMISSIONERS
 416 North State Street
 Jackson, Mississippi 39201

Bluff/67
Jm
22404
 CODED

WATER WELL DRILLERS LOG

April 1, 19 67 Layne-Central Company Leflore
 date well completed firm name county well located

LANDOWNER: Pee Dee Planting Co

description of formations encountered	from	to
Clay	0	26
Coarse sand	26	52
Coarse sand, pea gravel	52	107
Boulders		107

Schlater, Mississippi
 (mailing address)


WELL LOCATION:

sec 27 T 22 N R 2 E
 S W
7 miles S.E. of Ruleville
 (distance) (direction) (nearest town)

WELL PURPOSE: irrigation
 (home, irrigation, municipal, industrial)

WELL COMPLETION DATA:


- (1) diameter (inches) 16
- (2) total depth (feet) 107
- (3) static water level (feet) 16'1" ~~52'6"~~ above top of ground.
- (4) casing steel, 57'
 (material) (depth)
16" if telescope see back.
 (size)
- (5) screen 50', 107'
 (length) (depth to top)
16", Armco
 (size) (material)
- (6) pump 50, 2400
 (HP) (yield gpm)
electric
 (type power)
- (7) electric log no
 (yes or no)
 (organization running log)
- (8) how well bottom plugged _____

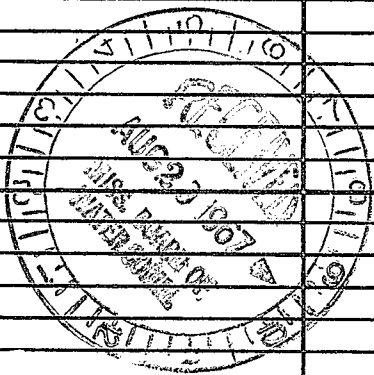

DRILLERS REMARKS:

If well telescopes please sketch and show depths.

GROUND LEVEL

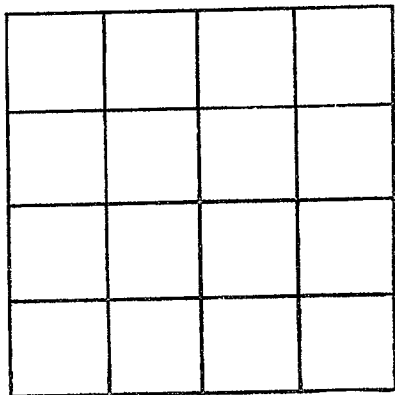

SECTION 27

Please indicate well location X.

ADDITIONAL INFORMATION

If more than one screen, show locations of each on sketch.