

LEFLORE
A 28
8-12-69
USGS

MISSISSIPPI
BOARD OF WATER COMMISSIONERS
416 North State Street
Jackson, Mississippi 39201
WATER WELL DRILLERS LOG

8-12 1969 DELTA DRILLING Co. LEFLORE
date well completed firm name county well located

LANDOWNER: F. T. LEAVELL
MINTER CITY
MISS
(mailing address)

WELL LOCATION:
sec. 20 T 22 N R 2 W
miles of (distance) (direction) (nearest town)

WELL PURPOSE:
(home, irrigation, municipal, industrial)

WELL COMPLETION DATA:

- (1) diameter (inches) 4
- (2) total depth (feet) 1200
- (3) static water level (feet) FLUWS below top of ground.
- (4) casing STEEL, 1180, (material) (depth)
4-3-12" if telescope see back. (size)
- (5) screen 20, 1180 (length) (depth to top)
2", STAINLESS STEEL (size) (material)
- (6) pump ✓ (HP) ✓ (yield gpm)
(type power)
- (7) electric log YES (yes or no)
U. S. G. S. (organization running log)
- (8) how well bottom plugged BACK PRESSURE VALVE


description of formations encountered	from	to
Gumbo	0	30
Sand	30	75
Gravel	75	125
Sand	125	186
Gumbo	186	232
Sand	232	270
Gumbo	270	284
Sand	284	418
Gumbo	418	487
Sand	487	510
Gumbo w/ROCKS.	510	590
Shale w/ROCKS	590	723
Sand w/ROCKS	723	766
Shale w/ROCKS	766	808
BROWN Sand	808	890
Shale	890	973
Gumbo	973	995
Shale	995	1004
BROWN Sand	1004	1034
Shale	1034	1070
Sand	1070	1090
Gumbo	1090	1108
WHITE Sand	1108	1200

DRILLERS REMARKS: 25' GAP OF 2" IN 3" PIPE

Aug 22 1969

MISSISSIPPI BOARD OF WATER COMMISSIONERS

If well telescopes please sketch and show depths.

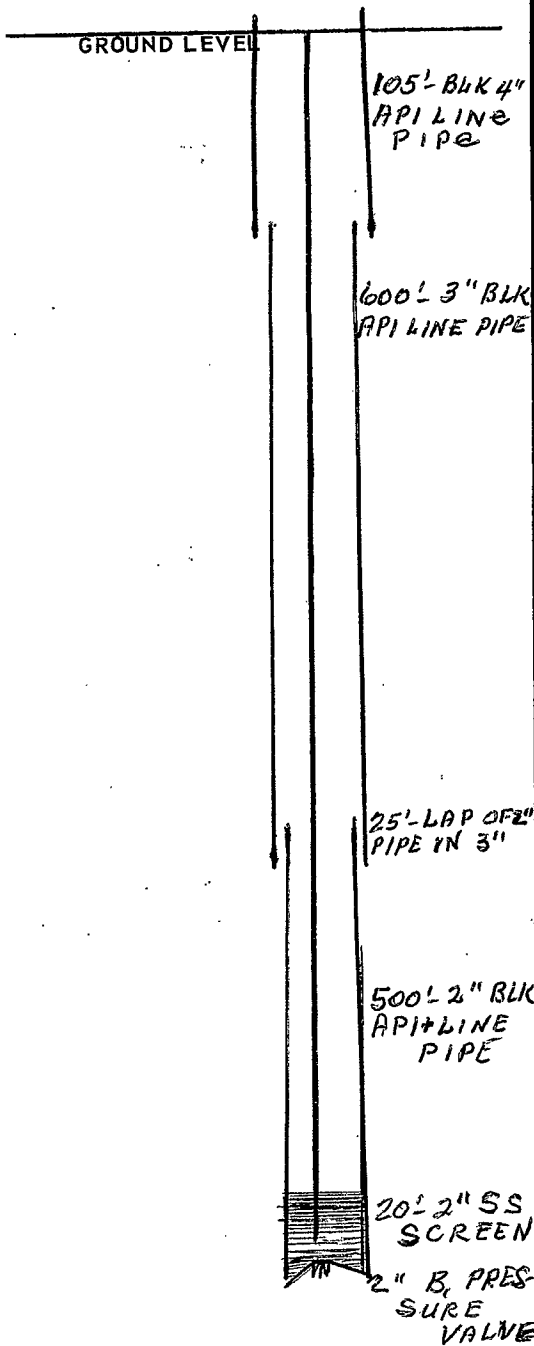

SECTION 20

Please indicate well location X.

ADDITIONAL INFORMATION

If more than one screen, show locations of each on sketch.