

Leflore  
A 30  
12-22-69

MISSISSIPPI  
BOARD OF WATER COMMISSIONERS  
416 North State Street  
Jackson, Mississippi 39201

CODED

CODED

WATER WELL DRILLERS LOG

Dec. 22 1969 date well completed  
DYER WELL & IRRIGATION SERVICE firm name  
Leflore county well located


LANDOWNER:	description of formations encountered	from	to
EQUEN PLANTING Co. Minter City, Miss. (mailing address)	CLAY SAND SAND + GRAVEL	0 33 53	33 53 113
<b>WELL LOCATION:</b>			
sec. 15 T 22 N R 2 E S W 4 1/2 miles NW of Minter City (distance) (direction) (nearest town)			
<b>WELL PURPOSE:</b> Ind. (home, irrigation, municipal, industrial)			
<b>WELL COMPLETION DATA:</b>			
(1) diameter (inches) 12			
(2) total depth (feet) 113			
(3) static water level (feet) 19 below above top of ground.			
(4) casing Steel 73 (material) (depth) 12" if telescope see back. (size)			
(5) screen 40' 73 (length) (depth to top)			
12" Steel (size) (material)			
(6) pump 35 2000 (HP) (yield gpm)			
Diesel (type power)			
(7) electric log NO (yes or no)			
(organization running log)			
(8) how well bottom plugged Plate			
<b>DRILLERS REMARKS:</b>			

JAN 26 1970

MISS. BD. OF  
WATER COMMISSIONERS

If well telescopes please sketch and show depths.

GROUND LEVEL

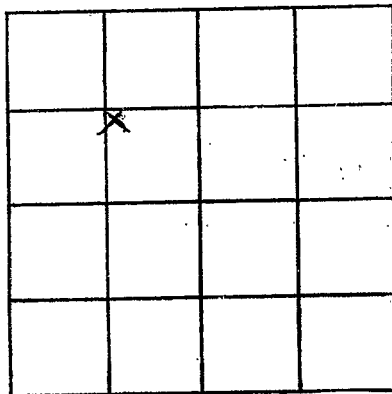

SECTION 15

Please indicate well location X.

ADDITIONAL INFORMATION

If more than one screen,  
show locations of each on sketch.