

ore
A-32

MISSISSIPPI BOARD OF WATER COMMISSIONERS

4/15/65
317

10-17-56

WATER WELL DRILLERS LOG

Date **CODED** 956, Driller: Layne-Central Company County, LaFlore

(Name)

CODED

(1) Owner of Land: C. S. Whittington
(Name)

Greenwood, Mississippi

(Address)

code 6

(2) Location: 1/4, 1/4, Sec. 29 T22R24

8 miles east of Ruleville
(distance) (direction) (Nearest Town)

(3) Topography: flat
(Hilly) (Flat) (Level)

(4) Purpose of Well: irrigation
(Domestic Irrigation
Municipal, Industrial, Other)

Description & Color of Materials Sand, Clay, Red Clay, Shell, etc.	Thick- ness Feet	Depth Feet
Clay	25	25
Fine sand	10	35
Coarse sand	13	48
Coarse sand & pea gravel	7	55
Coarse sand & gravel	33	88
Fine sand	3	91
Fine sand, pea gravel, lignite	3	94
Sand & gravel	9	103

Information upon completion of well:

(1) Diameter 16x12 inches.

(2) Total Depth 103 feet.

(3) Water Level 21'-3" feet below top of ground.

(4) Cased to 52'-2", Size 16"
2' swage

(5) Screen: Size 12", Length 50'

(6) Were any formations sealed against pollution?

no yes, no no.

If YES depth of formation _____


Why _____

Drillers Remarks: _____

2777 GPM

electric power

CODED

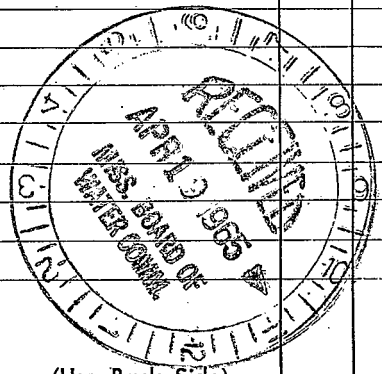

(Use Back Side)

Well No.

