

LEFLORE
A 34
8-27-72

MISSISSIPPI
 BOARD OF WATER COMMISSIONERS
 416 North State Street
 Jackson, Mississippi 39201

WATER WELL DRILLERS LOG

8-27 1972 DYER WELL & IRRIGATION SERVICE LEFLORE
 date well completed firm name county well located

CODED

LANDOWNER:	description of formations encountered	from	to
Milburn Farms Inc.	CLAY	0	22
RULEVILLE, MISS.	SAND	22	70
(mailing address)	SAND & GRAVEL	70	100
WELL LOCATION:	CLAY	100	102
sec. 23 T 22 N R 2 E	SAND & GRAVEL	102	170
4 miles W of WINTON CITY	CLAY	170	222
(distance) (direction) (nearest town)	SANDY SHALE	222	304
WELL PURPOSE: HOME & BLDG.	SAND	304	422
(home, irrigation, municipal, industrial)	SANDY SHALE	422	493
WELL COMPLETION DATA:	ROCK	493	495
(1) diameter (inches) 4" x 3"	SHALE	495	499
(2) total depth (feet) 882'	ROCK	499	500
(3) static water level (feet) Flow below top of ground.	SHALE	500	508
(4) casing BLK. IR. 852' (material) (depth)	SHALE & ROCK ST.	508	622
4" x 3" if telescope see back.	SHALE	622	680
(5) screen 30' 852' (length) (depth to top)	SHALE SAND ST.	680	795
3" STAINLESS STEEL (size) (material)	GUMMY SHALE	795	835
(6) pump 5 HP 55 (yield gpm)	SAND	835	882
ELEC. (type power)			
(7) electric log No (yes or no)			
(organization running log)			
(8) how well bottom plugged B.P.V.			
DRILLERS REMARKS:			


OCT 17 1972

MISS. BD. OF WATER COMM.

If well telescopes please sketch and show depths.

GROUND LEVEL

168 FT - 4" - TOP CASING
684 FT - 3" - LOWER CASING
30 FT - SCREEN ALL
DIRECT COMPLET

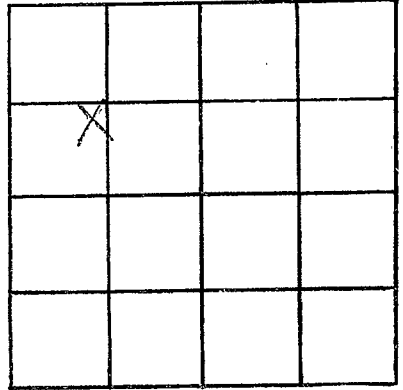

SECTION 23

Please indicate well location X.

ADDITIONAL INFORMATION

If more than one screen,
show locations of each on sketch.