

LEFLORE
A 35
2-23-73

MISSISSIPPI
BOARD OF WATER COMMISSIONERS
416 North State Street
Jackson, Mississippi 39201

CODED

WATER WELL DRILLERS LOG
DYER WELL & IRRIGATION SERVICE

LEFLORE

2-23-73 date well completed 1973 firm name LEFLORE county well located

LANDOWNER: Acie Zachary
WINTER CITY,
Miss.
(mailing address)

description of formations encountered	from	to
Clay	0	14
Muddy Sand & logs	14	32
Sand	32	50
Sand & gravel	50	168
Sand	168	290
Shale	290	342
Sand	342	452
Shaded Rock	452	493
Rock	493	495
Shale	495	499
Rock	499	500
Shale	500	512
Rock	512	513
Shale & Rock	513	622
Shale	622	755
Sand	755	785
Shale	785	802

WELL LOCATION:
sec. 15 T. 22 N. R. 2 W.
5 miles W of WINTER CITY
(distance) (direction) (nearest town)

WELL PURPOSE: Water
(home, irrigation, municipal, industrial)


- WELL COMPLETION DATA:
- (1) diameter (inches) 4" x 2"
 - (2) total depth (feet) 802
 - (3) static water level (feet) 3' below above top of ground.
 - (4) casing Bulk Pipe 782' (material) (depth) "
126" x 4" 656-2 (size) if telescope see back.
 - (5) screen 20" 782 (length) (depth to top)
2" STAINLESS STEEL (size) (material)
 - (6) pump 1 (HP) 30 (yield gpm)
ELEC (type power)
 - (7) electric log No (yes or no)
(organization running log)
 - (8) how well bottom plugged B.P.D.

DRILLERS REMARKS:

JUN 27 1973

If well telescopes please sketch and show depths.

GROUND LEVEL

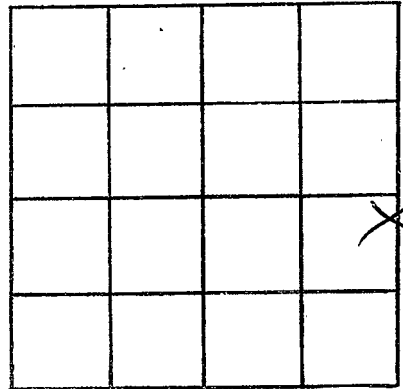

SECTION 15

Please indicate well location X.

ADDITIONAL INFORMATION

If more than one screen,
show locations of each on sketch.