

LEFLORE
A 36
5-31-73

MISSISSIPPI
 BOARD OF WATER COMMISSIONERS
 416 North State Street
 Jackson, Mississippi 39201

CODED

WATER WELL DRILLERS LOG

5/81 date well completed 1973 Delta Well Drilling Co. firm name Leflore county well located

LANDOWNER:
 H. M. Arant
 Rt. 1, Natchez, Miss.
 (mailing address)

description of formations encountered	from	to
Top soil	0	14
Fine sand & clay	18	36
Med. sand	36	50
Sand & fine gravel	50	92

WELL LOCATION:
 sec. 36 T. 22 N. R. 2 E. W. 3
 6 miles west Natchez, Miss.
 (distance) (direction) (nearest town)

WELL PURPOSE: Irrigation
 (home, irrigation, municipal, industrial)

- WELL COMPLETION DATA:**
- (1) diameter (inches) 16
 - (2) total depth (feet) 92
 - (3) static water level (feet) 21 below top of ground.
 - (4) casing steel (material), (depth)
 - (size) If telescope see back.
 - (5) screen 110 (length), (depth to top)
 16 (size), steel (material)
 - (6) pump 30 (HP), 2000 (yield gpm)
 LP Gas (type power)
 - (7) electric log 110 (yes or no)
 - (organization running log)
 - (8) how well bottom plugged Cement


CODED

JUL 30 1973

DRILLERS REMARKS:

If well telescopes please sketch and show depths.

GROUND LEVEL

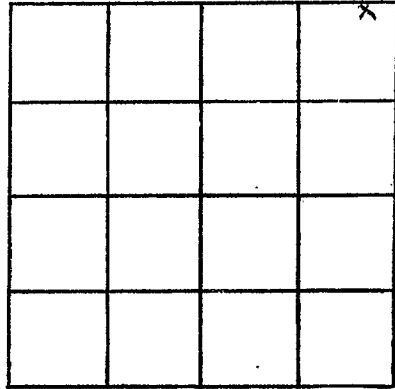

SECTION 33

Please indicate well location X.

ADDITIONAL INFORMATION

If more than one screen,
show locations of each on sketch.