

Leflore  
A 38  
4-21-62

MISSISSIPPI BOARD OF WATER COMMISSIONERS

WATER WELL DRILLERS LOG

MC 1282

Date: April 21, 1962, Driller: Layne-Central Company County Leflore

(Name)

(1) Owner of Land: Milburn Farms, Inc.

(Name)

Ruleville, Mississippi

(Address)

(2) Location: 1/4, 1/4, Sec. 22 T22N R2W

6 miles west of Minter City  
(distance) (direction) (Nearest Town)

(3) Topography: flat  
(Hilly) (Flat) (Level)

(4) Purpose of Well: irrigation  
(Domestic Irrigation  
Municipal, Industrial, Other)

Description & Color of Materials  
Sand, Clay, Red Clay, Shell, etc.

Thick-  
ness  
Feet

Depth  
Feet

Clay	38	38
Coarse sand, pea gravel	12	50
Coarse sand, pea gravel & gravel	55	105

CODED


Information upon completion of well:

- (1) Diameter 12 inches.
- (2) Total Depth 105 feet.
- (3) Water Level 8 feet below top of ground.
- (4) Cased to 65', Size 12"
- (5) Screen: Size 12", Length 40'
- (6) Were any formations sealed against pollution?  
no no.

If YES depth of formation \_\_\_\_\_

Why \_\_\_\_\_

Drillers Remarks: \_\_\_\_\_

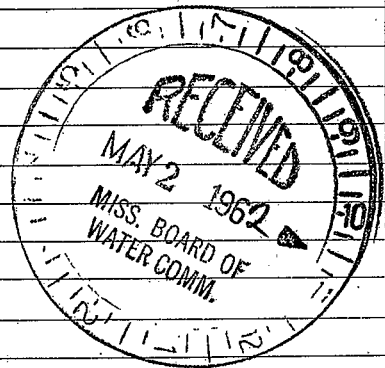

Well No.

(Use Back Side)

