

LEFLORE
A 41
10-7-74

MISSISSIPPI
BOARD OF WATER COMMISSIONERS
 416 North State Street
 Jackson, Mississippi 39201

CODED

WATER WELL DRILLERS LOG

10/7/74 1974 BUTANE GAS CO. OF GREENWOOD LeFlore
 date well completed firm name county well located

LANDOWNER:
A.D. Meredith
Midler City
 (mailing address)

WELL LOCATION:
 sec. 15 T. 22 N R. 2 E
5 miles NW of Midler City
 (distance) (direction) (nearest town)

WELL PURPOSE: Home
 (home, irrigation, municipal, industrial)

- WELL COMPLETION DATA:**
- (1) diameter (inches) 4 x 2
 - (2) total depth (feet) 999
 - (3) static water level (feet) 5 ^{below} above top of ground.
 - (4) casing Steel, 979,
 (material) (depth)
 - 4 x 2 if telescope see back.
 (size)
 - (5) screen 20, 979
 (length) (depth to top)
 - 2", Stainless
 (size) (material)
 - (6) pump 1 20
 (HP) (yield gpm)
 - Elec.
 (type power)
 - (7) electric log No
 (yes or no)

(organization running log)

(8) how well bottom plugged Lead Plug

DRILLERS REMARKS:

| description of formations encountered | from | to |
|---------------------------------------|------|------|
| Clay | 0 | 17 |
| SAND | 17 | 85 |
| GRAVEL | 85 | 135 |
| Shale | 135 | 205 |
| Sandy Shale | 205 | 314 |
| Green Sand | 314 | 478 |
| SAND + Shale streaks | 478 | 500 |
| Shale + Rock | 500 | 612 |
| Sandy Shale | 612 | 707 |
| Sandy Shale + Rock | 707 | 745 |
| Shale | 745 | 812 |
| Sandy Shale | 812 | 841 |
| SAND | 841 | 874 |
| SAND + Shale | 874 | 908 |
| SAND | 908 | 950 |
| SAND + Shale streaks | 950 | 970 |
| SAND | 970 | 989 |
| SHALE | 989 | 1021 |

RECEIVED
OCT 15 1974

MISS. BD. OF WATER


If well telescopes please sketch and show depths.

GROUND LEVEL

105' - 4" CASING →

874' - 2" CASING →

20' - 2" SCREEN →

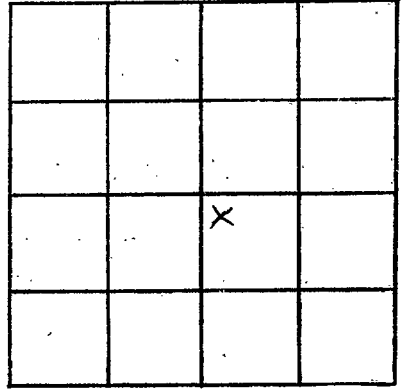

SECTION 10

Please indicate well location X.

ADDITIONAL INFORMATION

If more than one screen, show locations of each on sketch.