

LEFLORE

A 42

4-8-74

MISSISSIPPI
 BOARD OF WATER COMMISSIONERS
 416 North State Street
 Jackson, Mississippi 39201

CODED

WATER WELL DRILLERS LOG
 DYER WELL & IRRIGATION SERVICE

LEFLORE

APRIL 8, 1974
date well completed

firm name

county well located

LANDOWNER:

LAURE LINDSAY

Rayville, Miss.
(mailing address)

description of formations encountered

from

to

CLAY

0

21

SAND

21

34

SAND + PEAT ROCK

34

56

PEAT ROCK, SAND

56

GRAVEL

112

WELL LOCATION:

sec 33 T. 22 N. R. 2 E
7 miles N.W. of SHALATEL
 (distance) (direction) (nearest town)

WELL PURPOSE: DOM.
 (home, irrigation, municipal, industrial)

CODED

WELL COMPLETION DATA:

- (1) diameter (inches) 12"
- (2) total depth (feet) 112'
- (3) static water level (feet) 17' below above top of ground.
- (4) casing PVC, 72'
(material) (depth)
12" if telescope see back.
(size)
- (5) screen 40', 72'
(length) (depth to top)
12", BUE INCO
(size) (material)
- (6) pump 30 1800
(HP) (yield gpm)
- ELEC.
(type power)
- (7) electric log no
(yes or no)

(organization running log)


(8) how well bottom plugged PERTE

DRILLERS REMARKS:

RECORDED
 INDEXED
 NOV 21 1974

If well telescopes please sketch and show depths.

GROUND LEVEL

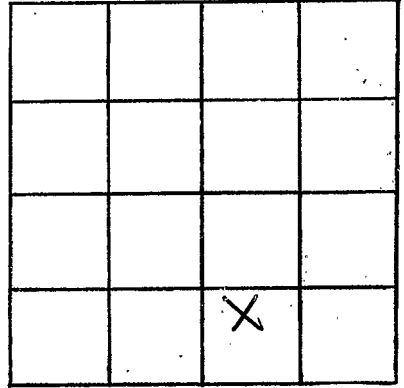

SECTION 33

Please indicate well location X.

ADDITIONAL INFORMATION

If more than one screen,
show locations of each on sketch.