

**LEFLORE**  
**A43**  
**3-11-75**

MISSISSIPPI  
 BOARD OF WATER COMMISSIONERS  
 416 North State Street  
 Jackson, Mississippi 39201

**WATER WELL DRILLERS LOG**

**BUTANE GAS CO. OF GREENWOOD**

*Leflore*

*3-11-75*  
 date well completed

firm name

county well located

**LANDOWNER:**  
*Jimmy Guest*  
*Winter City*  
 (mailing address)

description of formations encountered	from	to
<i>CLAY</i>	<i>0</i>	<i>10</i>
<i>SANDY CLAY</i>	<i>10</i>	<i>50</i>
<i>SANDY CLAY &amp; GRAVEL</i>	<i>50</i>	<i>55</i>
<i>SAND &amp; GRAVEL</i>	<i>55</i>	<i>98</i>

**WELL LOCATION:**  
 sec. ~~22~~ *22* T *22* (N) R *2* E  
 S W  
*3 1/2* miles *NW* of *Winter City*  
 (distance) (direction) (nearest town)


**WELL PURPOSE:**  
 (home, irrigation, municipal, industrial)

- WELL COMPLETION DATA:**
- (1) diameter (inches) *12"*
  - (2) total depth (feet) *98*
  - (3) static water level (feet) *17* below above top of ground.
  - (4) casing *Steel*, *58*  
 (material) (depth)  
*12"* If telescope see back.  
 (size)
  - (5) screen *49'*, *58*  
 (length) (depth to top)  
*12"*, *Steel*  
 (size) (material)
  - (6) pump *40*, *2000*  
 (HP) (yield gpm)  
*Diesel*  
 (type power)
  - (7) electric log *NO*  
 (yes or no)

(organization running log)

(8) how well bottom plugged


DRILLERS REMARKS:

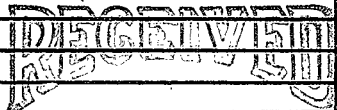

MAR 24 1975

If well telescopes please sketch and show depths.

GROUND LEVEL

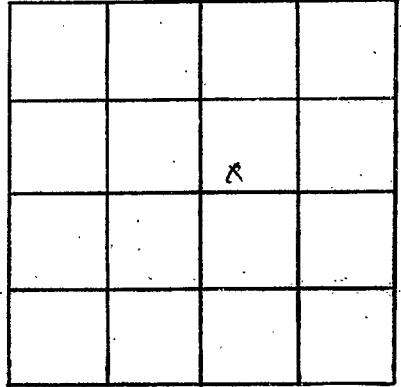

SECTION   C  

Please indicate well location X.

ADDITIONAL INFORMATION

A series of horizontal lines for writing additional information, starting below the 'ADDITIONAL INFORMATION' header and extending to the bottom of the page.

If more than one screen, show locations of each on sketch.