

Leflore
A44
 6-67

CODED

MISSISSIPPI
 BOARD OF WATER COMMISSIONERS
 416 North State Street
 Jackson, Mississippi 39201

WATER WELL DRILLERS LOG

Carver #1

June 1 19 67 Dyer Well & Irr. Ser. Leflore
 date well completed firm name county well located

LANDOWNER: N. W. Carver Jr.

description of formations encountered	from	to

R. R. Ruleville.

Clay	0	13
------	---	----

Mississippi
 (mailing address)

Soft brown clay	13	23
-----------------	----	----

WELL LOCATION:

sec. 30 T. 22 N. R. 2 E.
 7 miles East of Ruleville
 (distance) (direction) (nearest town)

Blue Clay	23	33
-----------	----	----

WELL PURPOSE: Irrigation
 (home, irrigation, municipal, industrial)

Blue clay & fine sand	33	43
-----------------------	----	----

WELL COMPLETION DATA:

(1) diameter (inches) 10"

Med. sand & small gravel	43	53
--------------------------	----	----

(2) total depth (feet) 100'

Coarse sand & sm. gr.	53	63
-----------------------	----	----

(3) static water level (feet) 15' below above top of ground.

" " " " "	63	73
-----------	----	----

(4) casing 68' 68'
 (material) (depth)
 Steel Pipe
 (size) if telescope see back.

" " " " "	73	83
-----------	----	----

(5) screen 32' 68'
 (length) (depth to top)
10' Blk Iron
 (size) (material)

Gravel (large)	83	93
----------------	----	----

(6) pump 28 1500
 (HP) (yield gpm)


Sand & gravel	93	103
---------------	----	-----

(7) electric log No
 (yes or no)
 (organization running log)

(8) how well bottom plugged plate
welded on bottom


DRILLERS REMARKS:

CODED

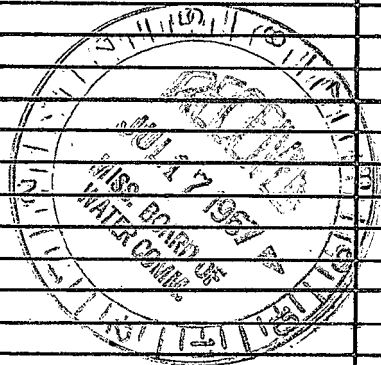

If well telescopes please sketch and show depths.

GROUND LEVEL

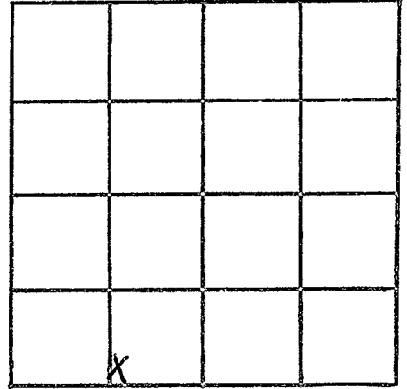

SECTION 3a

Please indicate well location X.

ADDITIONAL INFORMATION

If more than one screen, show locations of each on sketch.