

Leflore
A-45
6-67

MISSISSIPPI
 BOARD OF WATER COMMISSIONERS
 416 North State Street
 Jackson, Mississippi 39201

CODED

WATER WELL DRILLERS LOG

Carver #2

June 3 19 67 Dyer Well & Irr. Ser. Leflore
 date well completed firm name county well located

LANDOWNER: N. W. Carver Jr.
R. R. Ruleville.
Mississippi
 (mailing address)
 WELL LOCATION:
 sec 31 T. 22 N. R. 2 X
W
7 miles East of Ruleville
 (distance) (direction) (nearest town)

description of formations encountered	from	to
Clay	0	13
Blue mud	13	43
Med Sand	43	63
Coarse sand & pea gra.	63	103

WELL PURPOSE: Irrigation
 (home, irrigation, municipal, industrial)

CODED

WELL COMPLETION DATA:
 (1) diameter (inches) 10"
 (2) total depth (feet) 99'
 (3) static water level (feet) 15' below above top of ground.
 (4) casing Blk Iron, 67'
 (material) (depth)
 if telescope see back.
 (size)
 (5) screen 32', 67'
 (length) (depth to top)
10", Blk Irons
 (size) (material)
 (6) pump 28 1500
 (HP) (yield gpm)
tractor
 (type power)
 (7) electric log No
 (yes or no)


 (organization running log)
 (8) how well bottom plugged Steel
plate welded on bottom



DRILLERS REMARKS:

If well telescopes please sketch and show depths.

GROUND LEVEL

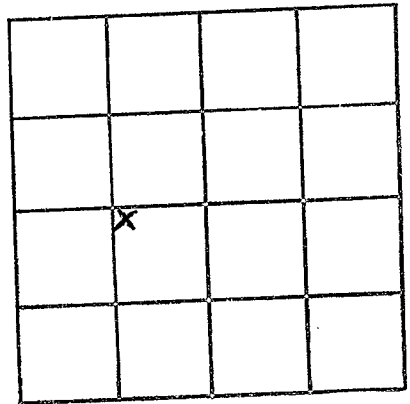

SECTION 31

Please indicate well location X.

ADDITIONAL INFORMATION

If more than one screen, show locations of each on sketch.