

Leflore
A 46
6-67

MISSISSIPPI
BOARD OF WATER COMMISSIONERS
416 North State Street
Jackson, Mississippi 39201

WATER WELL DRILLERS LOG Carver #3

June 7 1967 Dyer Well & Irr. Ser. Leflore
date well completed firm name county well located

LANDOWNER: N. W. Carver Jr.

R. R. Ruleville,

Mississippi
(mailing address)

WELL LOCATION:

sec 33 T 22 N R 2 E
W
7 miles East of Ruleville
(distance) (direction) (nearest town)

WELL PURPOSE: IRRIGATION
(home, irrigation, municipal, industrial)

WELL COMPLETION DATA:


- (1) diameter (inches) 10"
(2) total depth (feet) 103'
(3) static water level (feet) 15 below above top of ground.
(4) casing: Blk Ir., 71'
(material) (depth)
(size) if telescope see back.
(5) screen 32' 71'
(length) (depth to top)
10" Blk. Ir.
(size) (material)
(6) pump 28 1500
(HP) (yield gpm)
Tractor
(type power)
(7) electric log no
(yes or no)

(organization running log)
(8) how well bottom plugged Steel
Plate welded in bottom

DRILLERS REMARKS:


description of fomations encountered	from	to
Clay	0	13
Clay	13	23
Sand & Gravel	23	33
Coarse Sand	33	43
Coarse sand and small gravel	43	103

CODED

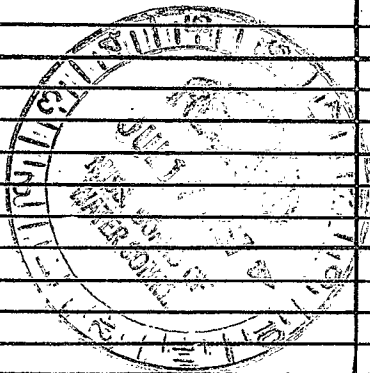

If well telescopes please sketch and show depths.

GROUND LEVEL

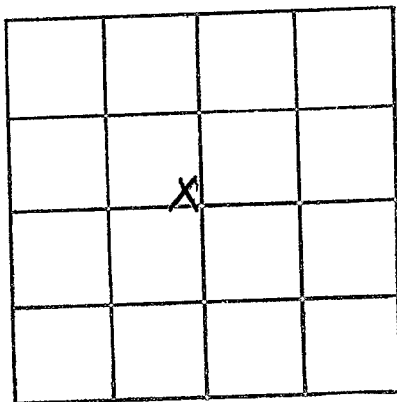

SECTION _____

Please indicate well location X.

ADDITIONAL INFORMATION

If more than one screen, show locations of each on sketch.