

LEFLORE
~~4-68~~ A47
 4-68

MISSISSIPPI
 BOARD OF WATER COMMISSIONERS
 416 North State Street
 Jackson, Mississippi 39201
 WATER WELL DRILLERS LOG

5/2/68
 Well # 2
 C2653

April 23, 1968 Layne-Central Company LeFlore
 date well completed firm name county well located

LANDOWNER: Milburn Farms, Inc

description of formations encountered	from	to
Clay	0	18
Fine sand	18	35
Coarse sand, pea gravel	35	90
Big boulders	90	108

Ruleville, Mississippi
 (mailing address)

WELL LOCATION: SW 1/4 SW 1/4
 sec. 27 T. 22 N R. 2 E
 S W City
 3 miles west of Minter
 (distance) (direction) (nearest town)

WELL PURPOSE: irrigation
 (home, irrigation, municipal, industrial)

WELL COMPLETION DATA:

- (1) diameter (inches) 16"
- (2) total depth (feet) 108'
- (3) static water level (feet) 15' 11" below top of ground.
- (4) casing steel, 58' (material), (depth), 16" (size) if telescope see back.
- (5) screen 50' (length), 108' (depth to top), 16" (size), Armco (material)
- (6) pump 50 (HP), 2000 (yield gpm), electric (type power)
- (7) electric log no (yes or no)
- (8) how well bottom plugged _____ plate


CODED

JUN 11 1968
 MISS. BOARD OF
 WATER COMMISSIONERS

DRILLERS REMARKS:

If well telescopes please sketch and show depths.

GROUND LEVEL

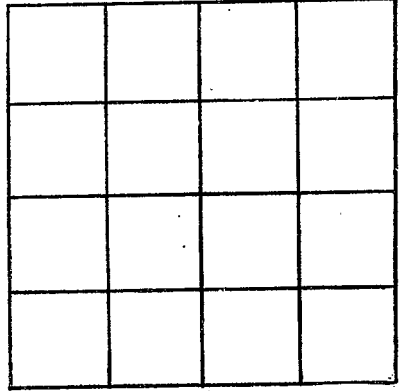

SECTION _____

Please indicate well location X.

ADDITIONAL INFORMATION

If more than one screen,
show locations of each on sketch.