

~~B-38~~ **A48**
 Date: July 20, 1964
 7-20-64

Driller: DELTA DRILLING CO. County LEFLORE
 (Name) **CODED**

(1) Owner of Land: MRS FISHER AVENT
 (Name)
MINNER CITY, MISS
 (Address)

(2) Location: NE 1/4, SE 1/4, Sec. 29 T22R2W
 _____ miles _____ of _____
 (distance) (direction) (Nearest Town)

(3) Topography: _____
 (Hilly) (Flat) (Level)

(4) Purpose of Well: DOMESTIC
 (Domestic Irrigation
 Municipal, Industrial, Other)

Description & Color of Materials Sand, Clay, Red Clay, Shell, etc:	Thick- ness Feet	Depth Feet
SAND	23	23
GUMBO	21	44
SAND	20	64
GRAVEL	89	153
GUMBO W/ROCKS	290	443
SHALE	144	587
GUMBO	5	592
GREEN SAND W/ROCKS	59	651
SHALE	60	711
GUMBO	40	751
SHALE	40	791
BROWN SAND CODED	50	841
SHALE	30	871
GUMBO	39	910
SHALE	20	930
SAND	28	958
GUMBO	23	981

Information upon completion of well:

(1) Diameter 3 inches.

(2) Total Depth 981 feet.

(3) Water Level FLOWS feet below top of ground.

(4) Cased to 961, Size 588-3"
386-2"
874


(5) Screen: Size 2", Length 20'

(6) Were any formations sealed against pollution?
 _____ yes, _____ no.

If YES depth of formation _____

Why _____

Drillers Remarks: 13' LAP OF 2"
IN 3" PIPE

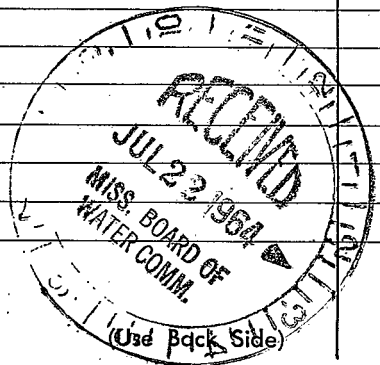

Well No. _____

