

LeFlore MISSISSIPPI BOARD OF WATER COMMISSIONERS

~~B39~~ A49

WATER WELL DRILLERS LOG

8-4-64

Date: AUG 4, 1964, Driller: DELTA DRILLING County LEFLORE

CODED

(Name)

(1) Owner of Land: B. C. STRAIN
(Name)
MINTER CITY, MISS
(Address)

(2) Location: SW 1/4, SE 1/4, Sec. 35 T22AR2W
_____ miles _____ of _____
(distance) (direction) (Nearest Town)

(3) Topography: _____
(Hilly) (Flat) (Level)

(4) Purpose of Well: DOMESTIC
(Domestic Irrigation
Municipal, Industrial, Other)

Information upon completion of well:

(1) Diameter 3 inches.

(2) Total Depth 1061 feet.

(3) Water Level FLOWS feet below top of ground. 3" 567

(4) Cased to 1019, Size 2" 474

(5) Screen: Size 2", Length 20'-SS


(6) Were any formations sealed against pollution?
_____ yes, _____ no. 5

If YES depth of formation _____

Why _____

Drillers Remarks: 13' LAP OF 2" IN 3"
PIPE - 12' - 2" TAIL PIPE
ON BOTTOM END OF WELL

Description & Color of Materials Sand, Clay, Red Clay, Shell, etc.	Thick- ness Feet	Depth Feet
GUMBO	30	30
SAND	18	48
GRAVEL	38	86
GUMBO	20	106
GRAVEL	28	134
GUMBO	225	359
SHALE	21	380
SAND	38	418
GUMBO	80	498
SHALE W/ROCKS	22	520
SAND W/ROCKS	27	547
GUMBO	22	569
SHALE W/ROCKS	40	609
GREEN SAND	20	629
SHALE W/ROCKS	20	649
SAND	13	662
GUMBO	36	698
SHALE	90	788
SAND	40	828
SHALE	19	847
BROWN SAND	21	868
FINE SILTY SAND	30	898
GUMBO	30	928
SAND	34	962
SHALE	26	988
GUMBO	14	1002
WHITE SAND	46	1048
GUMBO	13	1061

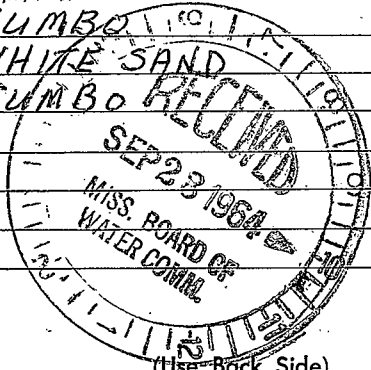

Well No.

