

**LEFLORE**  
**A 52**  
**4-26-76**

**MISSISSIPPI**  
**BOARD OF WATER COMMISSIONERS**  
 416 North State Street  
 Jackson, Mississippi 39201

**CODED**

**WATER WELL DRILLERS LOG**

4/26/76 19 BUTANE GAS CO. OF GREENWOOD Leflore  
 date well completed firm name county well located


LANDOWNER:	description of formations encountered	from	to
<u>Jimmy Guest</u>			
<u>Minster City</u> (mailing address)	<u>SAND</u>	<u>30</u>	<u>40</u>
<b>WELL LOCATION:</b>	<u>SAND + PER GRAVEL</u>	<u>40</u>	<u>60</u>
sec. <u>12</u> T <u>22</u> N R <u>2</u> E S <u>6</u> W	<u>SAND + GRAVEL</u>	<u>60</u>	<u>90</u>
<u>3 1/2</u> miles <u>NW</u> of <u>Minster City</u> (distance) (direction) (nearest town)			
<b>WELL PURPOSE:</b> <u>IRR.</u> (home, irrigation, municipal, industrial)			
<b>WELL COMPLETION DATA:</b>			
(1) diameter (inches) <u>16</u>	<b>CODED</b>		
(2) total depth (feet) <u>90</u>			
(3) static water level (feet) <u>17</u> below/above top of ground.			
(4) casing <u>Steel</u> <u>50</u> (material) (depth)			
<u>16</u> If telescope see back. (size)			
(5) screen <u>40</u> <u>50</u> (length) (depth to top)			
<u>16</u> <u>Steel</u> (size) (material)			
(6) pump <u>60</u> <u>3000</u> (HP) (yield gpm)			
<u>Diesel</u> (type power)			
(7) electric log <u>NO</u> (yes or no)			
(organization running log)			
(8) how well bottom plugged <u>Steel Plate</u>			
<b>DRILLERS REMARKS:</b>			

**DEC 1975**  
**APR 28 1976**

**MISS. Bd. OF WATER COMM.**

If well telescopes please sketch and show depths.

GROUND LEVEL

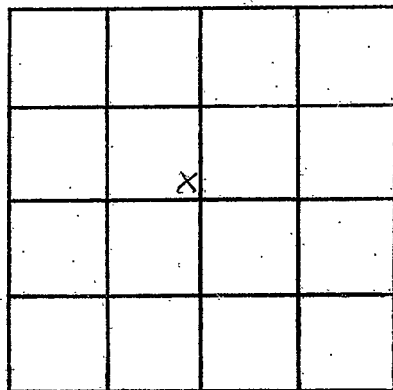

SECTION 12

Please indicate well location X.

ADDITIONAL INFORMATION

If more than one screen, show locations of each on sketch.