

LEFLORE

SUNFLOWER

A 56

5-30-77

MISSISSIPPI BOARD OF WATER COMMISSIONERS  
416 North State Street  
Jackson, Mississippi 39201

CODED

WATER WELL DRILLERS LOG

5-30  
date well completed

19 77

Layne Central Co.  
firm name

Sunflower  
county well located

LANDOWNER: Milburn Farms  
Ruleville, MS

(mailing address)

description of formations encountered

from

to

Topsoil

0

4

blue clay

4

40

coarse sand & pea gravel

40

95

gravel boulders

95

112

#1 WELL LOCATION:

sec. 21 T 22 N R 2 W

8 miles East of Ruleville  
(distance) (direction) (nearest town)

WELL PURPOSE: Irrigation  
(home, irrigation, municipal, industrial)

WELL COMPLETION DATA:

- (1) diameter (inches) 16"
- (2) total depth (feet) 112'
- (3) static water level (feet) 23' below top of ground.
- (4) casing Steel 67'  
(material) (depth)  
16" if telescope see back.  
(size)
- (5) screen 45' 67'  
(length) (depth to top)  
16" St. Steel  
(size) (material)
- (6) pump 60 2000  
(HP) (yield gpm)  
diesel  
(type power)
- (7) electric log No  
(yes or no)

(organization running log)

(8) how well bottom plugged St. Plate


DRILLERS REMARKS:

CODED

RECEIVED  
AUG 8 1977

If well telescopes please sketch and show depths.

GROUND LEVEL

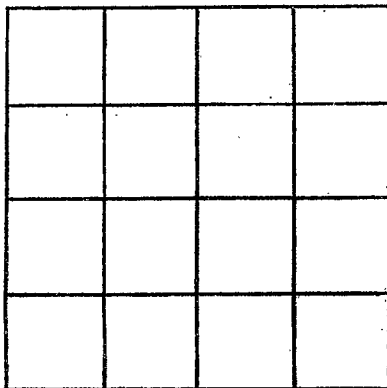

SECTION \_\_\_\_\_

Please indicate well location X.

ADDITIONAL INFORMATION

If more than one screen, show locations of each on sketch.