

LEFLORE

SUNFLOWER

A 57

C-2-11

MISSISSIPPI BOARD OF WATER COMMISSIONERS
416 North State Street
Jackson, Mississippi 39201

CODED

WATER WELL DRILLERS LOG

6-2 19 77 Layne Central Co. Sunflower
date well completed firm name county well located

LANDOWNER: Milburn Farms
Ruleville, MS
(mailing address)

description of formations encountered	from	to
	Topsoil	0
blue clay	4	20
coarse sand	20	40
coarse sand & gravel	40	80
gravel boulders	80	108

#2 WELL LOCATION:
sec. 22 T 22 N R 2 W
8 miles East of Ruleville
(distance) (direction) (nearest town)

WELL PURPOSE: Irrigation
(home, irrigation, municipal, industrial)

WELL COMPLETION DATA:

- (1) diameter (inches) 16"
- (2) total depth (feet) 108'
- (3) static water level (feet) 23' below top of ground.
- (4) casing Steel 58'
(material) (depth)
16"
(size) If telescope see back.
- (5) screen 50' 58'
(length) (depth to top)
16" St. Steel
(size) (material)
- (6) pump 40 1500
(HP) (yield gpm)
diesel
(type power)
- (7) electric log No
(yes or no)
(organization running log)
- (8) how well bottom plugged St. Plate

CODED


RECEIVED

AUG 8 1977

DRILLERS REMARKS:

If well telescopes please sketch and show depths.

GROUND LEVEL

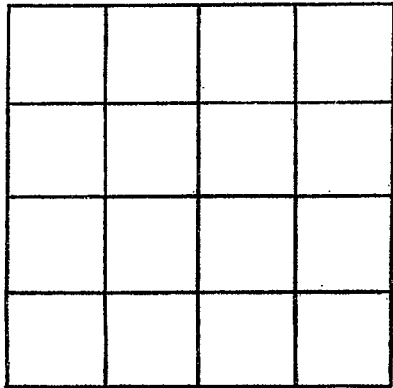

SECTION _____

Please indicate well location X.

ADDITIONAL INFORMATION

If more than one screen, show locations of each on sketch.