

LEFLORE
SUNFLOWER
A 58
4-30-77

MISSISSIPPI
 BOARD OF WATER COMMISSIONERS
 416 North State Street
 Jackson, Mississippi 39201

CODED

WATER WELL DRILLERS LOG

4-30 19 77 Layne Central Co. Sunflower
 date well completed firm name county well located


LANDOWNER:	description of formations encountered	from	to
Milburn Farms	Clay	0	20
Ruleville, MS	Med. coarse sand & P. gr.	20	23
(mailing address)	coarse sand & gravel	23	33
#3 WELL LOCATION:	coarse sand & gravel	33	43
sec. 22 T. 22 N R. 2 D	coarse sand & gravel	43	53
8 miles East of Ruleville	coarse sand & gravel	53	63
(distance) (direction) (nearest town)	gravel & coarse sand	63	73
WELL PURPOSE: Irrigation	gravel & coarse sand	73	83
(home, irrigation, municipal, industrial)	gravel & coarse sand	83	93
WELL COMPLETION DATA:	gravel & coarse sand	93	103
(1) diameter (inches) 16"			
(2) total depth (feet) 103'			
(3) static water level (feet) 24' below top of ground.			
(4) casing Steel 53' (material) (depth)			
16" (size) if telescope see back.			
(5) screen 50' 53' (length) (depth to top)			
16" (size) St. Steel (material)			
(6) pump 60 2000 (HP) (yield gpm)			
diesel (type power)			
(7) electric log No (yes or no)			
(organization running log)			
(8) how well bottom plugged St. Steel			
DRILLERS REMARKS:			

RECEIVED

AUG 6 1977

If well telescopes please sketch and show depths.

GROUND LEVEL

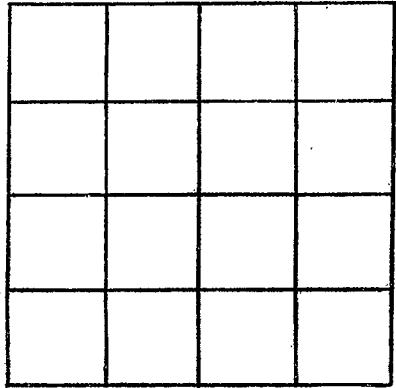

SECTION _____

Please indicate well location X.

ADDITIONAL INFORMATION

If more than one screen, show locations of each on sketch.