

LEFLORE
A62
8-14-78
Log #101

**MISSISSIPPI
BOARD OF WATER COMMISSIONERS**
416 North State Street
Jackson, Mississippi 39201

WATER WELL DRILLERS LOG

CODED

August 14 19 78 Bruce Berryman - Leflore county well located
date well completed firm name Greenwood, Miss.

LANDOWNER: Mr. N.W. Carver,
Rt. 1. Box 100
Ruleville, Miss.
(mailing address)

WELL LOCATION:
sec. 30 T. 92 N. R. 2 W.
7 miles W of Minter City
(distance) (direction) (nearest town)

WELL PURPOSE: Home
(home, irrigation, municipal, industrial)

- WELL COMPLETION DATA:**
- (1) diameter (inches) 4" x 2"
 - (2) total depth (feet) 1023 ft.
 - (3) static water level (feet) Flow above ~~126'~~
top of ground.
 - (4) casing 4" blk. galv. - 126'
2" galv. - 877'
(material) (depth)
 If telescope see back.
(size)
 - (5) screen 20' / 1003 ft.
(length) (depth to top)
.010 Stainless steel
(size) (material)
 - (6) pump 1 h.p. / 20
(HP) (yield gpm)
Electric
(type power)
 - (7) electric log Yes.
(yes or no)
 - Miss. Geological Survey
(organization running log)
 - (8) how well bottom plugged B.P.V.


description of fomations encountered	from	to
Clay	0	20
Sand	20	80
Sand & gravel	80	140
Clay	140	200
Sand	200	220
Clay	220	350
Sand	350	370
Clay	370	380
Sandy shale	380	420
Fine sand	420	460
Sand	460	540
Clay	540	580
Shale & Rocks	580	640
Sandy shale	640	660
Shale & Rocks	660	690
Green Sand	690	740
Shale & Rock	740	800
Shale	800	820
Fine sand	820	840
Shale & str. sand	840	930
Sand	930	950
Shale	950	1000
Sand	1000	1023
Clay	1023	1035

RECEIVED
JAN 11 1978
MISS. DD. OF WATER

DRILLERS REMARKS:

If well telescopes please sketch and show depths.

GROUND LEVEL

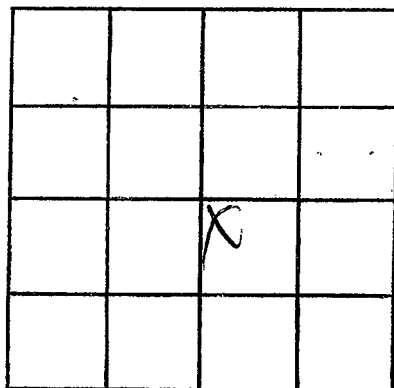

SECTION 30

Please indicate well location X.

ADDITIONAL INFORMATION

If more than one screen,
show locations of each on sketch.