

LEFLORE
A63
2/3/79

MISSISSIPPI
 BOARD OF WATER COMMISSIONERS
 416 North State Street
 Jackson, Mississippi 39201

CODED

WATER WELL DRILLERS LOG

February 3, 1979 Dyer Well & Irrigation Lefflore
 date well completed firm name county well located

LANDOWNER: Jimmy Guest
 Minter City, Miss.
 (mailing address)
 WELL LOCATION:
 sec. 14 T. 22N R. 2E
5 miles NW of Minter City
 (distance) (direction) (nearest town)

description of formations encountered	from	to
Clay	0	20
FINE SAND	20	30
SAND	30	45
SAND & GRAVEL	45	100
Bottom 100' - Rock		

WELL PURPOSE: Irrigation
 (home, irrigation, municipal, industrial)

CODED

WELL COMPLETION DATA:
 (1) diameter (inches) 16"
 (2) total depth (feet) 100'
 (3) static water level (feet) 13' below top of ground.
 (4) casing STEEL, 60'
 (material) (depth)
16" if telescope see back.
 (size)
 (5) screen 40', 60'
 (length) (depth to top)
16", STEEL
 (size) (material)
 (6) pump 40 2000
 (HP) (yield gpm)
Diesel
 (type power)
 (7) electric log No
 (yes or no)
 (organization running log)
 (8) how well bottom plugged Plate

DRILLERS REMARKS:


Miss. Board of Water Comm.

MAR 14 1979

RECEIVED

If well telescopes please sketch and show depths.

GROUND LEVEL

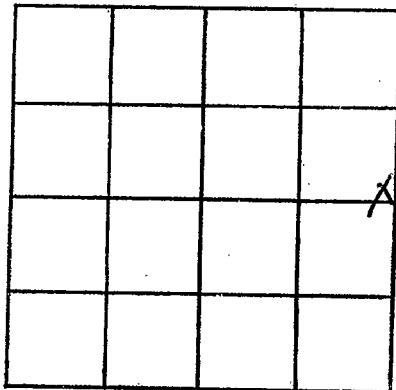

SECTION 14

Please indicate well location X.

ADDITIONAL INFORMATION

If more than one screen, show locations of each on sketch.