

LEFLORE

AG4

2-7-79

MISSISSIPPI  
 BOARD OF WATER COMMISSIONERS  
 416 North State Street  
 Jackson, Mississippi 39201

CODED

WATER WELL DRILLERS LOG

February 7, 1979 Dyer Well & Irrigation Leflore  
 date well completed firm name county well located


LANDOWNER: <u>Everett Almerbee</u>	description of formations encountered	from	to
<u>Minter City, Miss.</u> (mailing address)	<u>Clay</u>	<u>0</u>	<u>35</u>
	<u>Fine SAND</u>	<u>35</u>	<u>45</u>
	<u>SAND - MEDIUM</u>	<u>45</u>	<u>55</u>
	<u>SAND &amp; GRAVEL</u>	<u>55</u>	<u>98</u>
WELL LOCATION: sec. <u>33</u> T <u>22</u> N R <u>2</u> E <u>9</u> miles <u>W</u> of <u>Minter City</u> (distance) (direction) (nearest town)	<u>Bottom 98'</u>		
WELL PURPOSE: <u>Irrigation</u> (home, irrigation, municipal, industrial)			
WELL COMPLETION DATA:			
(1) diameter (inches) <u>16</u>			
(2) total depth (feet) <u>98'</u>			
(3) static water level (feet) <u>19'</u> above top of ground.			
(4) casing <u>Steel</u> , <u>58'</u> (material) (depth)			
<u>1 1/2"</u> if telescope see back. (size)			
(5) screen <u>40"</u> , <u>58'</u> (length) (depth to top)			
<u>1 1/2"</u> , <u>Steel</u> (size) (material)			
(6) pump <u>40</u> <u>1800-2000</u> (HP) (yield gpm)			
<u>Diesel</u> (type power)			
(7) electric log <u>No</u> (yes or no)			
(organization running log)			
(8) how well bottom plugged <u>Plate</u>			
DRILLERS REMARKS:			

CODED

*Rich 9-24-79*

If well telescopes please sketch and show depths.

GROUND LEVEL

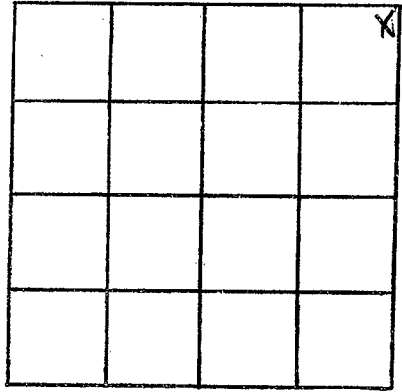

SECTION 33

Please indicate well location X.

ADDITIONAL INFORMATION

If more than one screen, show locations of each on sketch.