

LeFlores
467
10-25-79

MISSISSIPPI
 BOARD OF WATER COMMISSIONERS
 416 North State Street
 Jackson, Mississippi 39201

CODED

WATER WELL DRILLERS LOG
 BUTANE GAS COMPANY
 OF GREENWOOD

LeFlores
 county well located

10/25/79 19
 date well completed

LANDOWNER:	description of formations encountered	from	to
<u>Sykes Sturdivant</u>			
<u>Gledora</u> (mailing address)	<u>Clay</u>	<u>0</u>	<u>10</u>
	<u>SAND</u>	<u>10</u>	<u>40</u>
	<u>Sand + Gravel</u>	<u>40</u>	<u>105</u>
WELL LOCATION:			
sec <u>3</u> T <u>2^N</u> R <u>2^E</u> S ₄ W			
<u>5</u> miles <u>NW</u> of <u>Winston City</u> (distance) (direction) (nearest town)			
WELL PURPOSE: <u>FRK</u> (home, irrigation, municipal, industrial)			
WELL COMPLETION DATA:			
(1) diameter (inches) <u>16"</u>			
(2) total depth (feet) <u>105</u>			
(3) static water level (feet) <u>20</u> below top of ground. above			
(4) casing <u>Steel</u> , <u>65</u> (material) (depth)			
<u>16"</u> (size) if telescope see back.			
(5) screen <u>40'</u> , <u>65</u> (length) (depth to top)			
<u>16"</u> , <u>Steel</u> (size) (material)			
(6) pump <u>60</u> <u>2500</u> (HP) (yield gpm)			
<u>Diesel</u> (type power)			
(7) electric log <u>NO</u> (yes or no)			
<u></u> (organization running log)			
(8) how well bottom plugged <u>Steel pipe + seal</u>			
DRILLERS REMARKS:			


DEPT. OF NATURAL RESOURCES
 BUREAU OF LAND & WATER RESOURCES

NOV - 9 1979

RECEIVED

If well telescopes please sketch and show depths.

GROUND LEVEL

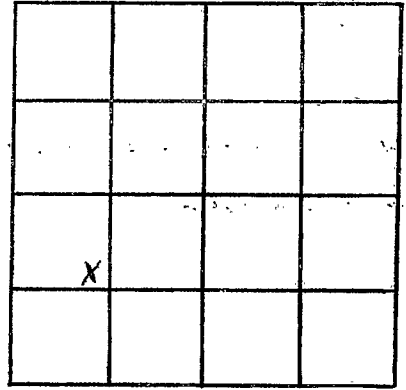

SECTION 3

Please indicate well location X.

ADDITIONAL INFORMATION

If more than one screen, show locations of each on sketch.