

LEFLORE

A-68

05/15/80
5-15

date well completed

1980

OF GREENWOOD

county well located

MISSISSIPPI
BOARD OF WATER COMMISSIONERS CODED
416 North State Street
Jackson, Mississippi 39201

WATER WELL DRILLERS LOG
BUTANE GAS COMPANY

LEFLORE

LANDOWNER

CONWAY FARMS

description of formations encountered

from

to

ITHA BENA, MS

38941

(mailing address)

CLAY	0	15
SAND	15	70
SAND & GRAVEL	70	130
SAND	130	210
CLAY	210	300
SAND	300	360
CLAY	360	440
GREEN SHALE	440	640
CLAY	640	720
FINE SAND	720	880
CLAY CODED	880	903
FINE SAND	903	1014
SAND	1014	1108

WELL LOCATION:

sec 25 T 22 N R 2 E
2 1/2 miles WEST of WINTER CITY
(distance) (direction) (nearest town)

WELL PURPOSE:

(home, irrigation, municipal, industrial)

WELL COMPLETION DATA:

- (1) diameter (inches) 4x2
- (2) total depth (feet) 1103
- (3) static water level (feet) 30 below top of ground.
- (4) casing STEEL, 1073 (material) (depth)
4x2 (size) if telescope see back.
- (5) screen 30, 1073 (length) (depth to top)
2" STAINLESS (size) (material)
- (6) pump 2, 40 (HP) (yield gpm)
ELECTRIC (type power)
- (7) electric log No (yes or no)

(organization running log)

- (8) how well bottom plugged BACK PRESSURE VALVE

DRILLERS REMARKS:

DEPT. OF NATURAL RESOURCES
BUREAU OF LAND & WATER RESOURCES

MAY 19 1980

RECEIVED


If well telescopes please sketch and show depths.

GROUND LEVEL

105' - 4" CASING →

968' - 2" CASING →

30' - 2" SCREEN →

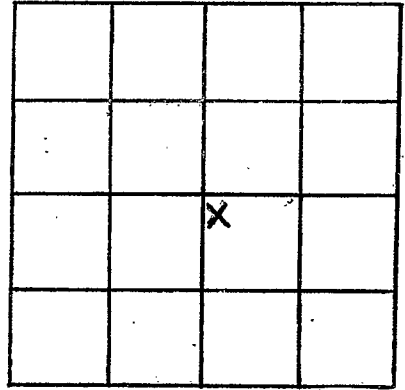

SECTION 25

Please indicate well location X.

ADDITIONAL INFORMATION

If more than one screen, show locations of each on sketch.