

MISSISSIPPI  
 BOARD OF WATER COMMISSIONERS  
 416 North State Street  
 Jackson, Mississippi 39201

CODED

WATER WELL DRILLERS LOG

1980 BUTANE GAS COMPANY  
 OF GREENWOOD

LEFFLORE  
 county well located

A-69  
 7/25/80  
 7-25  
 date well completed

LANDOWNER: A.D. MERIDETH  
MINNER CITY, MS

description of formations  
 encountered

from to

(mailing address)

CLAY	1	30
FINE SAND	30	40
SAND & GRAVEL	40	93

WELL LOCATION:

sec. 3 T 22 N R 2 E  
5 miles NW of MINNER CITY  
 (distance) (direction) (nearest town)

WELL PURPOSE: IRRIGATION  
 (home, irrigation, municipal, industrial)

CODED

WELL COMPLETION DATA:

- diameter (inches) 16"
  - total depth (feet) 93'
  - static water level (feet) \_\_\_\_\_ below  
 top of ground. above
  - casing STEEL, 53'  
 (material) (depth)  
16" if telescope see back.  
 (size)
  - screen 40', 53'  
 (length) (depth to top)  
16", STEEL  
 (size) (material)
  - pump 60, 2500  
 (HP) (yield gpm)  
DIESEL  
 (type power)
  - electric log No  
 (yes or no)
- (organization running log)

DEPT. OF NATURAL RESOURCES  
 BUREAU OF LAND & WATER RESOURCES

AUG 6 1980


RECEIVED

DRILLERS REMARKS:

(8) how well bottom plugged  
STEEL PLATE

If well telescopes please sketch and show depths.

GROUND LEVEL

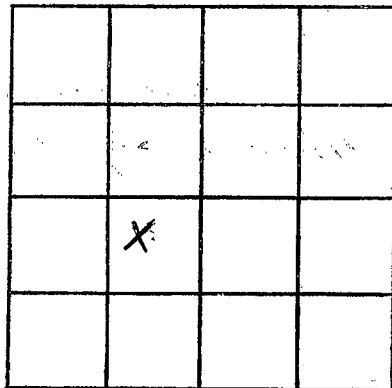

SECTION 3

Please indicate well location X.

ADDITIONAL INFORMATION

If more than one screen, show locations of each on sketch.