

MISSISSIPPI DEPARTMENT OF NATURAL RESOURCES

Bureau of Land and Water Resources

Southport Mall

P.O. Box 10631

Jackson, Mississippi 39209

CODED

WATER WELL DRILLERS LOG

LeFlore  
A71  
5-2-81

5-2 1981 date well completed      Deje Well & Log firm name      LeFlore county well located

LANDOWNER: D. W. Conner

Winter City  
(mailing address)

WELL LOCATION:  
sec. 30 T 22 N R 2 E  
S W  
6 miles EAST of Ridgely  
(distance) (direction) (nearest town)

WELL PURPOSE:  
(home, irrigation, municipal, industrial)

WELL COMPLETION DATA:

- (1) diameter (inches) 16"
- (2) total depth (feet) 113'
- (3) static water level (feet) 20' below top of ground.
- (4) casing Steel, 113'  
(material) (depth)  
16" if telescope see back.  
(size)
- (5) screen 40', 73'  
(length) (depth to top)  
16", Steel  
(size) (material)
- (6) pump 60, 3000  
(HP) (yield gpm)  
diesel  
(type power)
- (7) electric log NO  
(yes or no)  
  
(organization running log)
- (8) how well bottom plugged plate

description of formations encountered	from	to
<u>sand</u>	<u>13</u>	<u>23</u>
<u>sand</u>	<u>23</u>	<u>33</u>
<u>sand</u>	<u>33</u>	<u>43</u>
<u>sand</u>	<u>43</u>	<u>53</u>
<u>sand &amp; gravel</u>	<u>53</u>	<u>63</u>
<u>sand &amp; gravel</u>	<u>63</u>	<u>73</u>
<u>gravel</u>	<u>73</u>	<u>83</u>
<u>gravel</u>	<u>83</u>	<u>93</u>
<u>sand &amp; gravel</u>	<u>93</u>	<u>103</u>
<u>sand &amp; gravel</u>	<u>103</u>	<u>113</u>

DRILLERS REMARKS:


DEPT. OF NATURAL RESOURCES  
BUREAU OF LAND & WATER RESOURCES

MAY 19 1981

RECEIVED

If well telescopes please sketch and show depths.

GROUND LEVEL

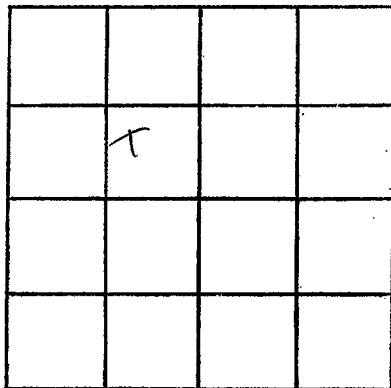

SECTION 30

Please indicate well location X.

ADDITIONAL INFORMATION

If more than one screen,  
show locations of each on sketch.