

MISSISSIPPI DEPARTMENT OF NATURAL RESOURCES

Bureau of Land and Water Resources

Southport Mall

P.O. Box 10631

CODED

Jackson, Mississippi 39209

WATER WELL DRILLERS LOG

LeFlone
A 72
12/31/80

12/31/80
date well completed

1980 Larry's Well & Pump
firm name

LeFlone
county well located

LANDOWNER: Wendall Chudy

description of formations encountered	from	to
CLAY	0	70
FINE SAND	20	45
COURSE SAND & GRAVEL	45	105

Cleveland, Ms.
(mailing address)

WELL LOCATION:

sec. 25 T 22 N R 7 E
6 miles W of Mentz
(distance) (direction) (nearest town)

WELL PURPOSE:

(home, irrigation, municipal, industrial)


WELL COMPLETION DATA:

- (1) diameter (inches) 16"
- (2) total depth (feet) 105'
- (3) static water level (feet) 20' below top of ground
- (4) casing Steel 65' (material) (depth)
(size) if telescope see back.
- (5) screen 40' 65' (length) (depth to top)
16" Steel (size) (material)
- (6) pump 60 3000 (HP) (yield gpm)
electric (type power)
- (7) electric log No (yes or no)

(organization running log)


(8) how well bottom plugged Steel Plate

DRILLERS REMARKS:

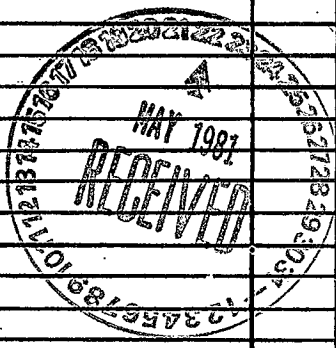

If well telescopes please sketch and show depths.

GROUND LEVEL

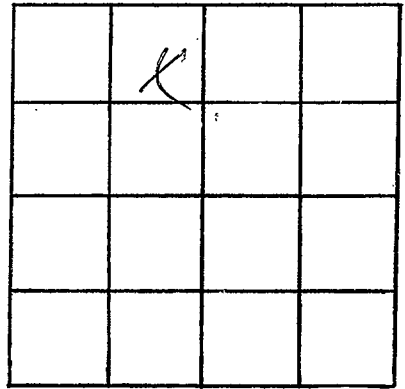

SECTION 25

Please indicate well location X.

ADDITIONAL INFORMATION

If more than one screen,
show locations of each on sketch.