

**MISSISSIPPI DEPARTMENT OF NATURAL RESOURCES**  
**Bureau of Land and Water Resources**  
 Southport Mall  
 P.O. Box 10631  
 Jackson, Mississippi 39209  
**WATER WELL DRILLERS LOG**

**CODED**

Leflore  
VA 73  
4-28-81

4-28 19 81 Dyer Leflore  
 date well completed firm name county well located

**LANDOWNER:**  
Prudential Insurance  
513 White Station  
Memphis, TN 38117  
Master City - Hwy #8  
 (mailing address)


description of formations encountered	from	to
<u>bdly clay</u>	<u>0</u>	<u>15</u>
<u>fine sand</u>	<u>15</u>	<u>54</u>
<u>med. sand &amp; gravel</u>	<u>54</u>	<u>85</u>
<u>coarse sand &amp; gravel</u>	<u>85</u>	<u>113</u>

**WELL LOCATION:**  
25 sec. 22 T. 22 N. 2 R. 2 E.  
2 miles W of Master City  
 (distance) (direction) (nearest town)

**WELL PURPOSE:** Irrigation  
 (home, irrigation, municipal, industrial)

- WELL COMPLETION DATA:**
- (1) diameter (inches) 16"
  - (2) total depth (feet) 113'
  - (3) static water level (feet) 18' <sup>2</sup> below above top of ground.
  - (4) casing Steel, 113'  
 (material) (depth)  
16" If telescope see back.  
 (size)
  - (5) screen 40', 23'  
 (length) (depth to top)  
16", Steel  
 (size) (material)
  - (6) pump 60, 3000  
 (HP) (yield gpm)  
 (type power)
  - (7) electric log \_\_\_\_\_  
 (yes or no)  
 (organization running log)
  - (8) how well bottom plugged plate


**CODED**

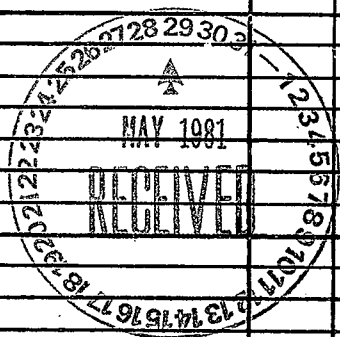

**DRILLERS REMARKS:**

If well telescopes please sketch and show depths.

GROUND LEVEL

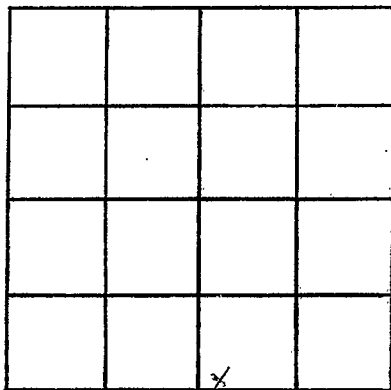

SECTION 25

Please indicate well location X.

ADDITIONAL INFORMATION

If more than one screen, show locations of each on sketch.